

MAKANA KAI AT WEHILANI - PHASE I

ARCHITECT'S CERTIFICATE

MICHAEL N. GOSHI of Design Partners Incorporated hereby certifies he is a registered professional architect (No. 5402) in Hawaii, that the attached Sheets CPR-0.1 and CPR-0.2, revised as of October 2012, to be filed in the Bureau of Conveyances of the State of Hawaii, are accurate copies of portions of the plans of the buildings in the condominium project known as "Makana Kai at Wehilani – Phase I" as filed with the County of Hawaii officer having jurisdiction over the issuance permits for the construction of buildings, that said Sheets CPR-0.1 and CPR-0.2, revised as of October 2012, supersede and replace Sheets CPR-0.1 and CPR-0.2, which were attached to the Architect's Certificate of the undersigned dated June 20, 2006, and filed as part of Condominium File Plan No. 4294, and that upon substitution of the attached Sheets CPR-0.1 and CPR-0.2, revised as of October 2012, Condominium File Plan No. 4294, as amended, fully and accurately depicts the layout, location, boundaries, dimensions, and numbers of the units in Buildings 25 to 38, inclusive, substantially as built in the condominium project known as "Makana Kai at Wehilani – Phase I".

DATED: Honolulu, Hawaii, October 31, 2012.




MICHAEL N. GOSHI  
Registered Professional  
Architect No. 5402

Subscribed and sworn to before me  
this 31 day of October, 2012,  
by Michael N. Goshi.

Document Description: Architect's Certificate  
Doc. Date: 10/31/2012 No. Pages: 1



Typed or Printed Name: Ruriko Tremblay  
Notary Public, First Judicial Circuit  
State of Hawaii

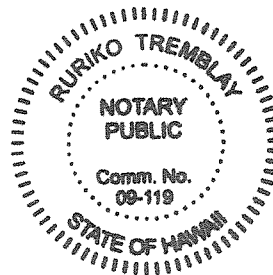

My commission expires: April 12, 2013




**Design Partners Incorporated**  
 Architecture  
 Planning  
 Interior Design



Signature  
**APR 30, 2012**  
 EXPIRES DATE OF LICENSE  
 No. 5402  
 This work was prepared by me or under my supervision and control. I am a duly licensed professional architect in the State of Hawaii.

Revision Number/Description

**Makana Kai**  
 At Wehilani  
 PHASE I  
 WAIKOLOA, SOUTH KOHALA, HAWAII  
 CASTLE & COOKE WAIKOLOA, LLC

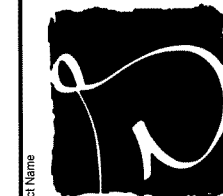

Project Name  
 Drawing Title  
 SITE PLAN - PHASE I


Project Number 03033-02 Date OCTOBER 2012  
 Drawn CAD Checked CS Designed LT/C5/M3

Drawing Number

**CPR-0.1**

Sheet No. of


**BUILDING KEY**

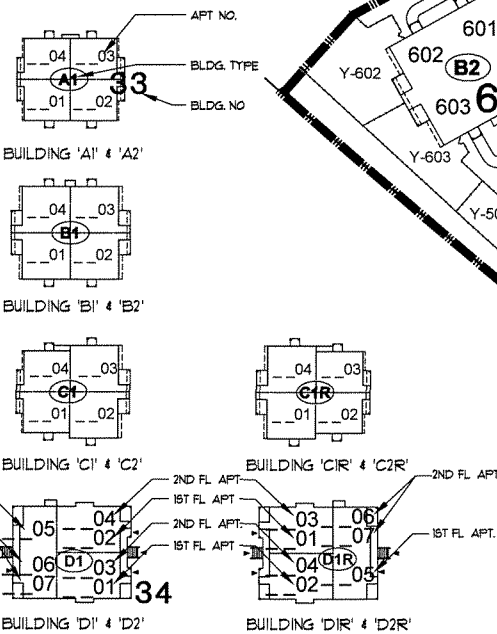

THIS CONDOMINIUM MAP MAY CONTAIN FLOOR PLANS AND ELEVATIONS OF APARTMENT TYPES THAT ARE NOT INCLUDED IN THIS PROJECT. PLEASE REFER TO THE SITE PLAN TO DETERMINE THE APARTMENT TYPES THAT ARE INCLUDED IN THIS PROJECT.


THE ELEVATIONS AND FLOOR PLANS SHOWN ARE FAIR REPRESENTATION TO ASSIST THE PUBLIC IN VISUALIZING THE CONDOMINIUM UNITS AND MAY NOT BE ACCURATELY DEPICTED. THE DEVELOPER, ITS AGENTS, ASSOCIATE COMPANIES AND SUPPLIERS RESERVE THE RIGHT TO MODIFY PLANS, SPECIFICATIONS AND FEATURES WITHOUT PRIOR NOTICE OR OBLIGATION. FOR SPECIFIC INFORMATION ON ANY OF THE ABOVE ELEMENTS, PLEASE CONTACT CASTLE & COOKE WAIKOLOA, LLC.

**METHOD OF COMPUTING FLOOR AREA**  
 THE FLOOR AREA OF THE APARTMENT OR UNIT SHALL BE COMPUTED AND REPORTED IN THE DECLARATION AND COMMISSION'S PUBLIC REPORT AS NET LIVING AREA. THE LIVING AREA OF THE ENCLOSED PORTION OF THE APARTMENT SHALL BE MEASURED FROM THE INTERIOR SURFACES OF THE APARTMENT PERIMETER WALLS. AREAS OF LANAI OR BALCONY, WHICH ARE CONSIDERED AS PART OF THE APARTMENT, SHALL BE COMPUTED AND REPORTED SEPARATE FROM THE ENCLOSED APARTMENT AREA.  
 (EFF. 6/12/81) (AUTH. HRS. SECT. 514A-45) (11"FP SECT. 514A-11(2))

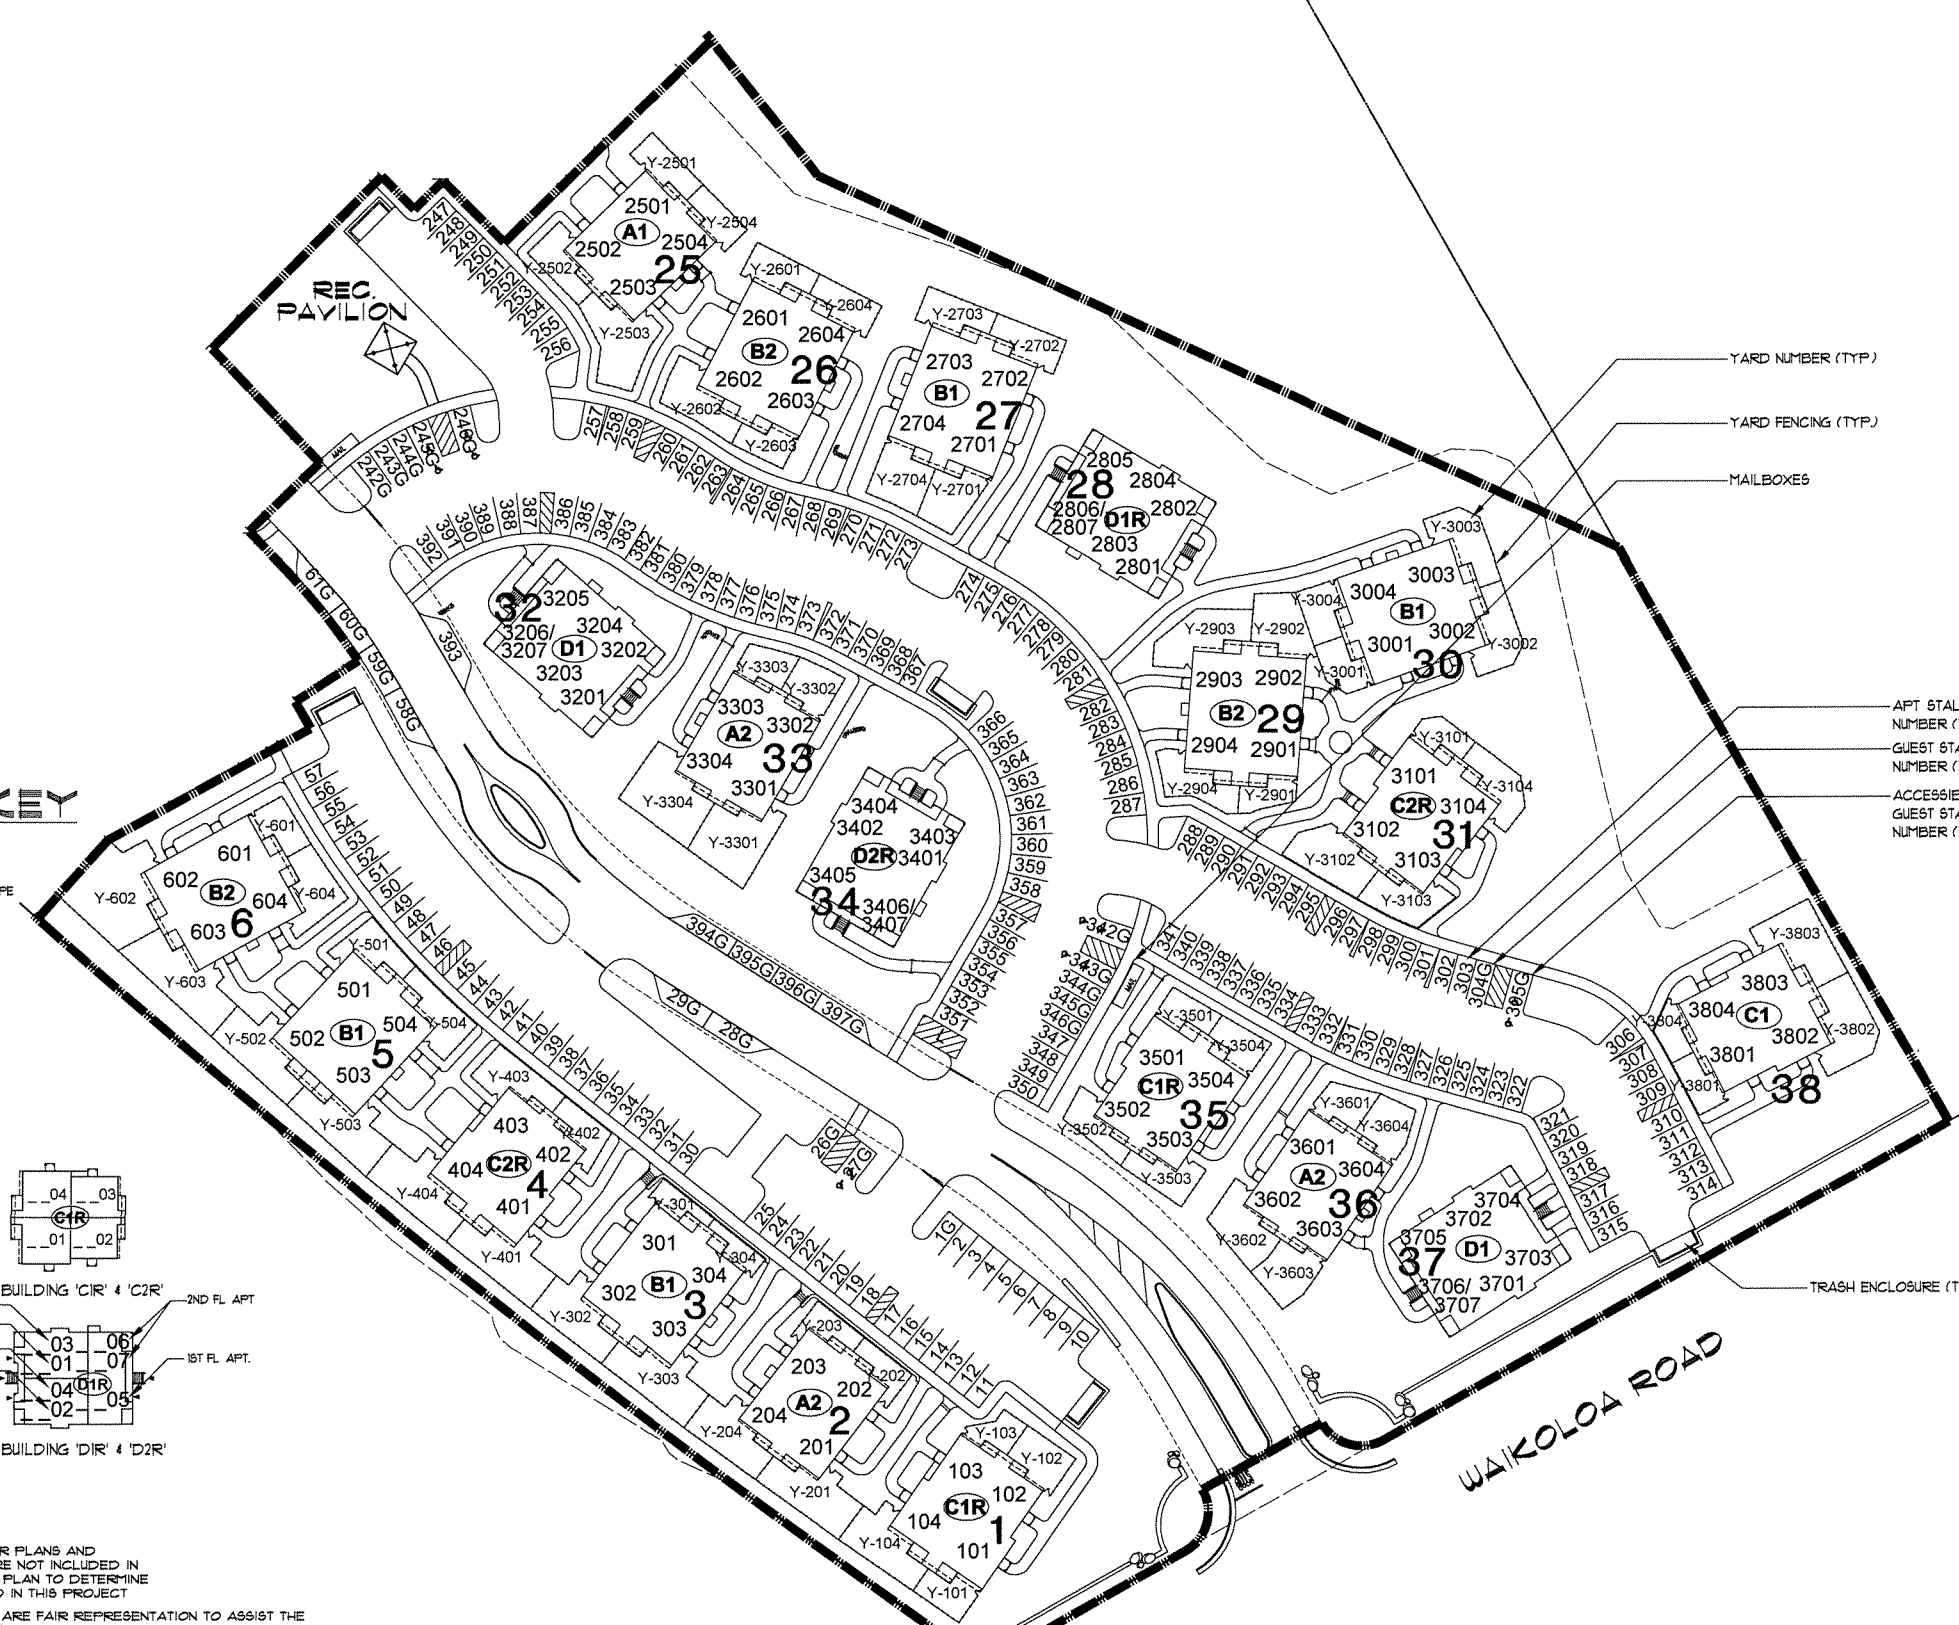


- YARD NUMBER (TYP.)
- YARD FENCING (TYP.)
- MAILBOXES
- APT. STALL NUMBER (TYP.)
- GUEST STALL NUMBER (TYP.)
- ACCESSIBLE GUEST STALL NUMBER (TYP.)
- TRASH ENCLOSURE (TYP.)




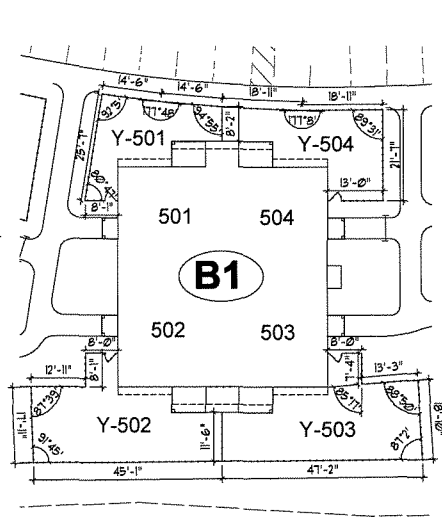


5 FENCE PLAN - BUILDING 5  
 CPR-02 SCALE NTS

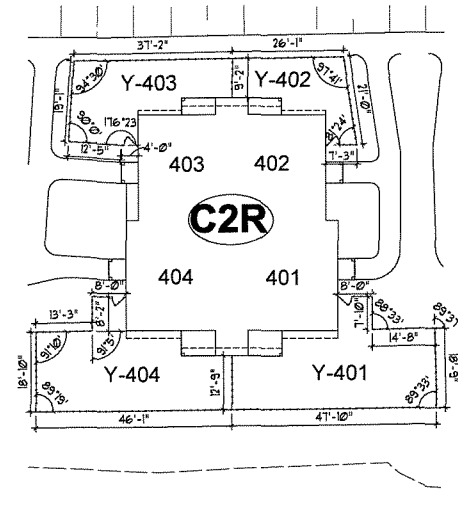


4 FENCE PLAN - BUILDING 4  
 CPR-02 SCALE NTS

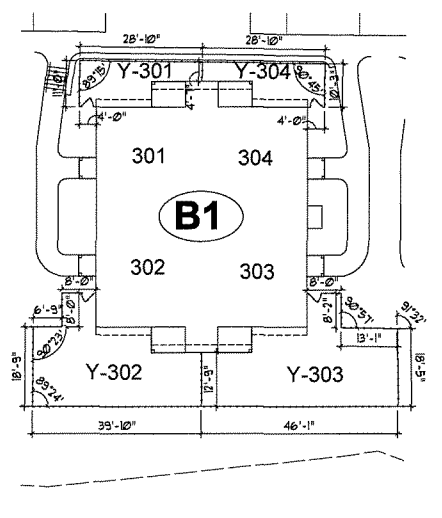


3 FENCE PLAN - BUILDING 3  
 CPR-02 SCALE NTS

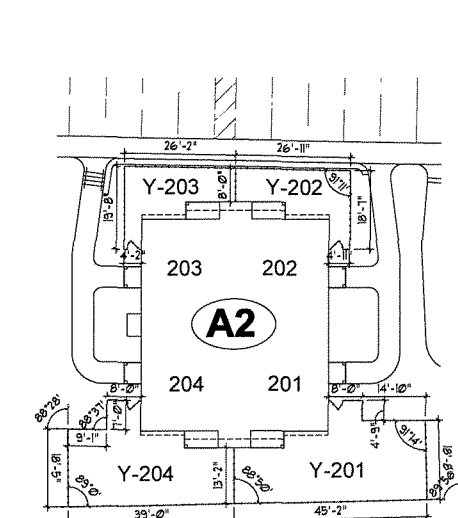


2 FENCE PLAN - BUILDING 2  
 CPR-02 SCALE NTS

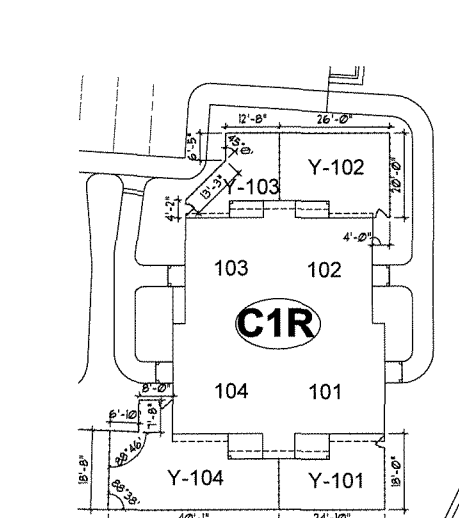


1 FENCE PLAN - BUILDING 1  
 CPR-02 SCALE NTS

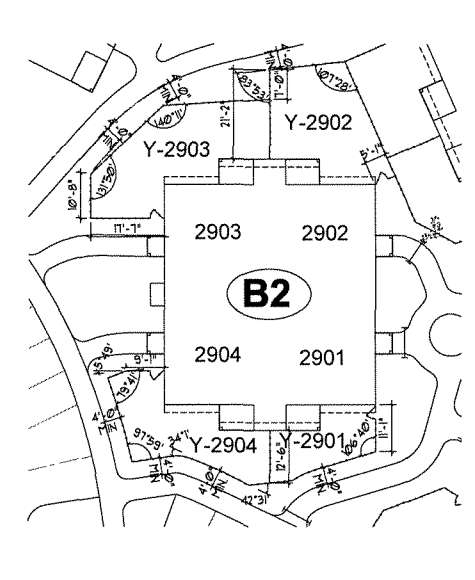


10 FENCE PLAN - BUILDING 29  
 CPR-02 SCALE NTS

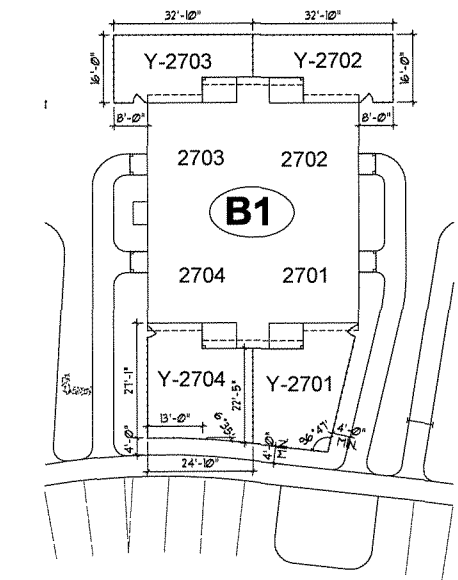


9 FENCE PLAN - BUILDING 27  
 CPR-02 SCALE NTS

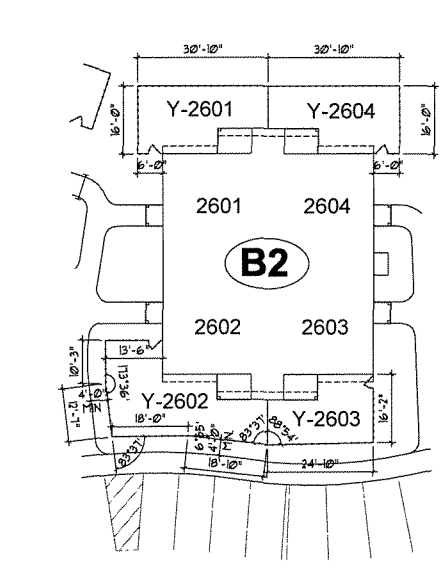

8 FENCE PLAN - BUILDING 26  
 CPR-02 SCALE NTS

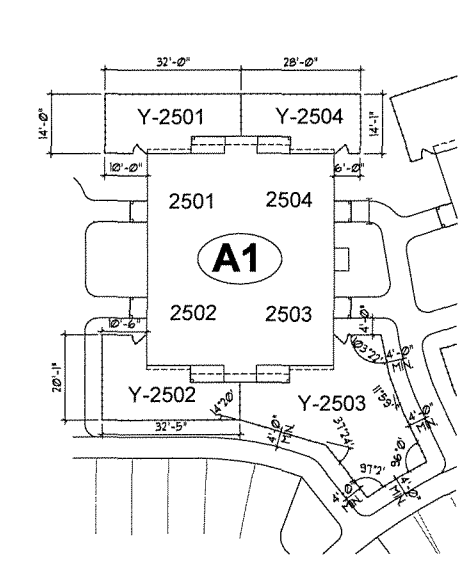

7 FENCE PLAN - BUILDING 25  
 CPR-02 SCALE NTS

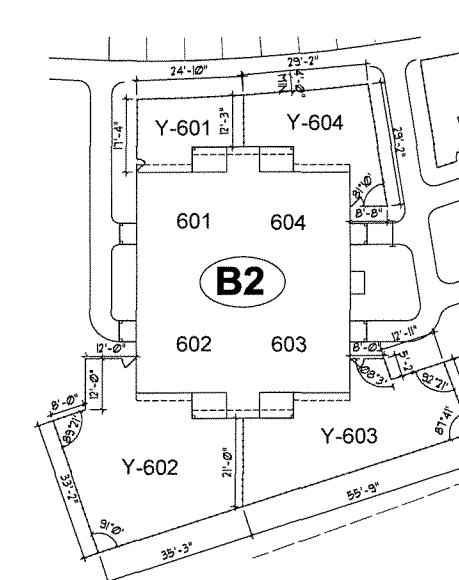

6 FENCE PLAN - BUILDING 6  
 CPR-02 SCALE NTS


THIS CONDOMINIUM MAP MAY CONTAIN FLOOR PLANS AND ELEVATIONS OF APARTMENT TYPES THAT ARE NOT INCLUDED IN THIS PROJECT. PLEASE REFER TO THE SITE PLAN TO DETERMINE THE APARTMENT TYPES THAT ARE INCLUDED IN THIS PROJECT.

THE ELEVATIONS AND FLOOR PLANS SHOWN ARE FAIR REPRESENTATION TO ASSIST THE PUBLIC IN VISUALIZING THE CONDOMINIUM UNITS AND MAY NOT BE ACCURATELY DEPICTED. THE DEVELOPER, ITS AGENTS, ASSOCIATE COMPANIES AND SUPPLIERS RESERVE THE RIGHT TO MODIFY PLANS, SPECIFICATIONS AND FEATURES WITHOUT PRIOR NOTICE OR OBLIGATION. FOR SPECIFIC INFORMATION ON ANY OF THE ABOVE ELEMENTS, PLEASE CONTACT CASTLE & COOKE WAIKOLOA LLC.

METHOD OF COMPUTING FLOOR AREA  
 THE FLOOR AREA OF THE APARTMENT OR UNIT SHALL BE COMPUTED AND REPORTED IN THE DECLARATION AND COMMISSION'S PUBLIC REPORT AS NET LIVING AREA. THE LIVING AREA OF THE ENCLOSED PORTION OF THE APARTMENT SHALL BE MEASURED FROM THE INTERIOR SURFACES OF THE APARTMENT PERIMETER WALLS. AREAS OF LANAI OR BALCONY, WHICH ARE CONSIDERED AS PART OF THE APARTMENT, SHALL BE COMPUTED AND REPORTED SEPARATE FROM THE ENCLOSED APARTMENT AREA (EFF. 6/12/81) (AUTH: HRS SECT. 514A-45) (IMP: SECT 514A-11(2))

Revision Number/Description


**Makana Kai**  
 At Wehilani  
 PHASE I  
 WAIKOLOA, SOUTH KOHALA, HAWAII  
 CASTLE & COOKE WAIKOLOA, LLC

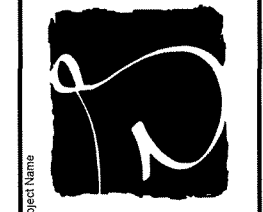

Project Name: Makana Kai At Wehilani

Drawing Title: FENCING PLANS

Project Number	Date	
03033-01	OCTOBER, 2012	
Drawn	Checked	Designed
CAD	CS	LT/CS/MG
Drawing Number		
CPR-0.2		
Sheet No. of		

MAKANA KAI AT WEHILANI – PHASE I

ARCHITECT'S CERTIFICATE


MICHAEL N. GOSHI of Design Partners Incorporated hereby certifies that he is a licensed architect (No. 5402) in Hawaii, and that the attached plans, consisting of 20 pages, filed in the Bureau of Conveyances of the State of Hawaii as Condominium File Plan No. 4294, are consistent with the plans of the buildings in the condominium project known as "Makana Kai at Wehilani – Phase I" filed or to be filed with the County of Hawaii officer having jurisdiction over the issuance of permits for the construction of buildings.

DATED: Honolulu, Hawaii, 20 June 20, 2006.




MICHAEL N. GOSHI  
Licensed Architect No. 5402

Subscribed and sworn to  
before me this 20th day  
of June, 2006.

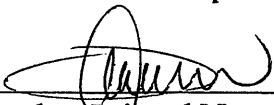

Typed or Printed Name: Florencia Asuncion  
Notary Public, State of Hawaii

My commission expires: 11/15/2010

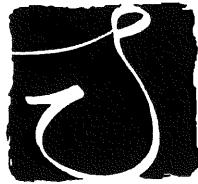

A MULTI-FAMILY CONDOMINIUM DEVELOPMENT FOR  
**CASTLE & COOKE WAIKOLOA, LLC**  
**MAKANA KAI AT WEHILANI**  
**PHASE I**

ARCHITECT: DESIGN PARTNERS INCORPORATED

**C.P.R. DOCUMENT SET**


JUNE 2006

- BUILDING TYPE 'A1' & 'A2'
- BUILDING TYPE 'B1' & 'B2'
- BUILDING TYPE 'C1'
- BUILDING TYPE 'C1R' & 'C2R'
- BUILDING TYPE 'D1'
- BUILDING TYPE 'D1R' & 'D2R'



Revision Number/Description


VICINITY MAP

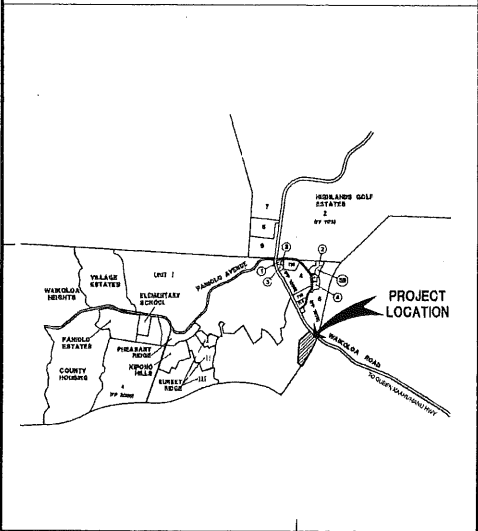

APARTMENT TYPES

PHASE I					
BUILDINGS 1 (TYPE A1)	BUILDINGS 2 (TYPE A2)	BUILDINGS 3 (TYPE B1)	BUILDINGS 4 (TYPE B2)	BUILDINGS 5 (TYPE C1)	BUILDINGS 6 (TYPE C2)
APT. NO.	APT. TYPE	APT. NO.	APT. TYPE	APT. NO.	APT. TYPE
101	2R	2501	1R	3201	2R
102	1'	2502	1'	3202	2'
103	1R	2503	1R	3203	2R
104	2'	2504	1'	3204	2'
201	1R	2601	2R	3101	2R
202	1'	2602	2'	3102	1'
203	1R	2603	2R	3103	1R
204	1'	2604	2'	3104	2'
301	2R	2701	2R	3201	3'
302	2'	2702	2'	3202	3R
303	2R	2703	2R	3203	3A'
304	2'	2704	2'	3204	3AR
401	2R	2801	3'	3205	4'
402	1'	2802	3R	3206	5R
403	1R	2803	3A'	3207	5'
404	2'	2804	3AR	3208	1R
501	2R	2805	4R	3301	1'
502	1'	2806	5R	3302	1R
503	2R	2807	5'	3304	1'
504	2'	2901	2R	3401	3'
601	2R	2902	2'	3402	3R
602	2'	2903	2R	3403	3A'
603	2R	2904	2'	3404	3AR
604	2'			3405	4R
				3406	5R
				3407	5'

INDEX OF DRAWINGS

SHEET NO.	DRAWING NO.	DESCRIPTION
1	CPR-00	TITLE SHEET
2	CPR-01	SITE PLAN - PHASE I
3	CPR-02	FENCING PLANS
4	CPR-03	FENCING PLANS, PAVILION FLOOR PLAN & SECTION
5	CPR-10	BUILDING TYPE 'A' FLOOR PLANS
6	CPR-11	BUILDING TYPE 'A1' EXTERIOR ELEVATIONS
7	CPR-12	BUILDING TYPE 'A2' EXTERIOR ELEVATIONS
8	CPR-20	BUILDING TYPE 'B' FLOOR PLANS
9	CPR-21	BUILDING TYPE 'B1' EXTERIOR ELEVATIONS
10	CPR-22	BUILDING TYPE 'B2' EXTERIOR ELEVATIONS
11	CPR-30	BUILDING TYPE 'C' FLOOR PLANS
12	CPR-31	BUILDING TYPE 'C1' EXTERIOR ELEVATIONS
13	CPR-33	BUILDING TYPE 'C1R' FLOOR PLANS
14	CPR-34	BUILDING TYPE 'C1R' EXTERIOR ELEVATIONS
15	CPR-35	BUILDING TYPE 'C2R' EXTERIOR ELEVATIONS
16	CPR-40	BUILDING TYPE 'D' FLOOR PLANS
17	CPR-41	BUILDING TYPE 'D1' EXTERIOR ELEVATIONS
18	CPR-43	BUILDING TYPE 'D1R' FLOOR PLANS
19	CPR-44	BUILDING TYPE 'D1R' EXTERIOR ELEVATIONS
20	CPR-45	BUILDING TYPE 'D2R' EXTERIOR ELEVATIONS

**Makana Kai**  
**At Wehilani**  
 PHASE I  
 WAIKOLOA, SOUTH KOHALA, HAWAII  
 CASTLE & COOKE WAIKOLOA, LLC



Project Name

Drawing Title: TITLE SHEET


Project Number: 02033-07 Date: JUNE 8, 2006  
 Drawn: CAC Checked: CS Designated: LYC/MS

Drawing Number

**CPR-0.0**

Sheet No. of


**BUILDING KEY**

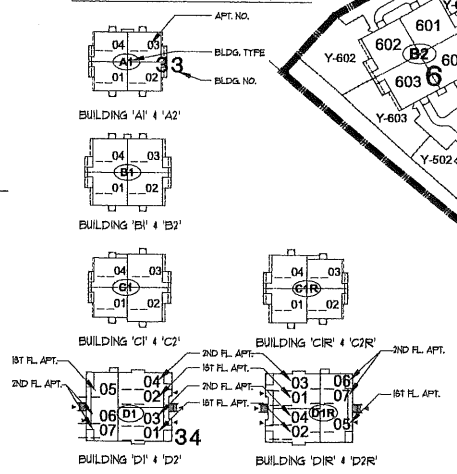

THIS CONDOMINIUM MAP MAY CONTAIN FLOOR PLANS AND ELEVATIONS OF APARTMENT TYPES THAT ARE NOT INCLUDED IN THIS PROJECT. PLEASE REFER TO THE SITE PLAN TO DETERMINE THE APARTMENT TYPES THAT ARE INCLUDED IN THIS PROJECT.

THE ELEVATIONS AND FLOOR PLANS SHOWN ARE FAIR REPRESENTATION TO ASSIST THE PUBLIC IN VISUALIZING THE CONDOMINIUM UNITS AND MAY NOT BE ACCURATELY DEPICTED. THE DEVELOPER, ITS AGENTS, ASSOCIATE COMPANIES AND SUPPLIERS RESERVE THE RIGHT TO MODIFY PLANS, SPECIFICATIONS AND FEATURES WITHOUT PRIOR NOTICE OR OBLIGATION. FOR SPECIFIC INFORMATION ON ANY OF THE ABOVE ELEMENTS, PLEASE CONTACT CASTLE & COOKE WAIKOLOA LLC.

**METHOD OF COMPUTING FLOOR AREA**  
 THE FLOOR AREA OF THE APARTMENT OR UNIT SHALL BE COMPUTED AND REPORTED IN THE DECLARATION AND COMMISSION'S PUBLIC REPORT AS NET LIVING AREA. THE LIVING AREA OF THE ENCLOSED PORTION OF THE APARTMENT SHALL BE MEASURED FROM THE INTERIOR SURFACES OF THE APARTMENT PERIMETER WALLS, AREAS OF LANAI OR BALCONY WHICH ARE CONSIDERED AS PART OF THE APARTMENT, SHALL BE COMPUTED AND REPORTED SEPARATE FROM THE ENCLOSED APARTMENT AREA.  
 (REF. 6/10/81) (AUTH: HRS SECT. 514A-45) (IMP. SECT. 514A-112)

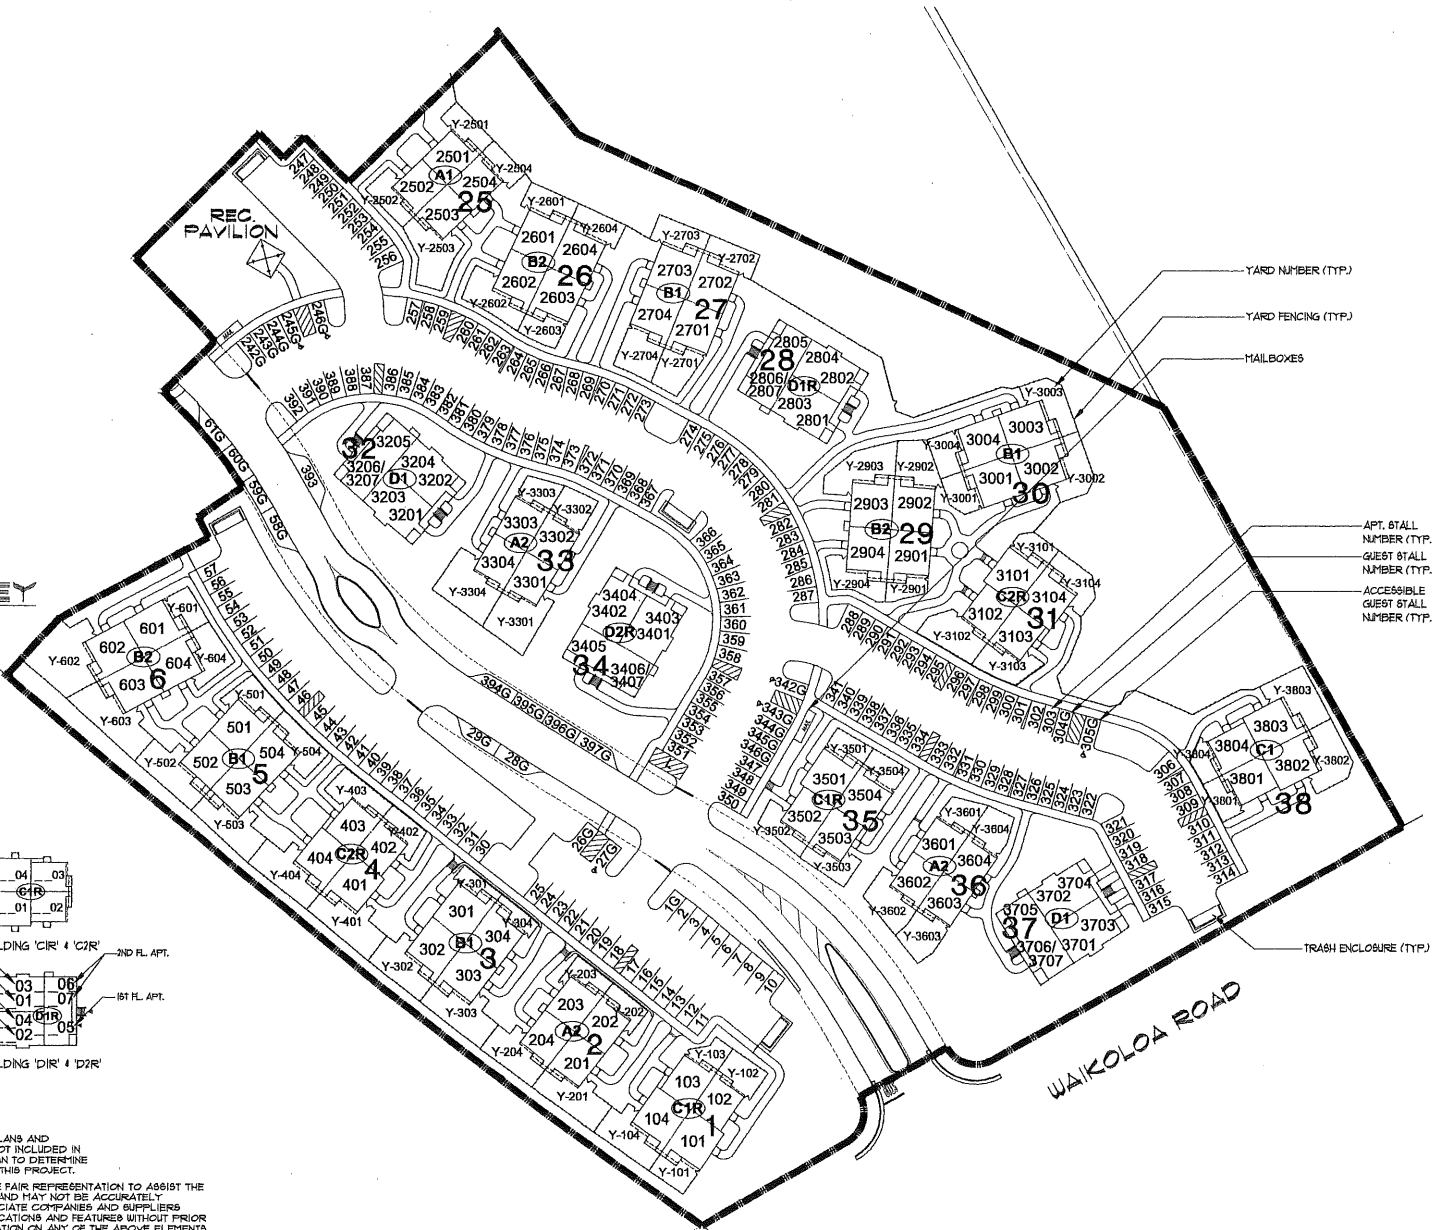


**1 SITE PLAN - PHASE I**  
 SCALE: NTS

Revision Number/Description


**Makana Kai**  
 At Wehilani  
 PHASE I  
 WAIKOLOA, SOUTH KOHALA, HAWAII  
 CASTLE & COOKE WAIKOLOA, LLC




Drawing Title		SITE PLAN PHASE I	
Project Number	09/03/02	Date	JUNE 8, 2008
Drawn	CAD	Checked	CS
Designed	LT/CS/PJS		
Drawing Number			
<b>CPR-0.1</b>			
Sheet No. of			

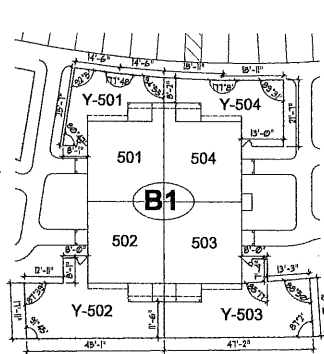


5 FENCE PLAN - BUILDING B  
CPR-0.2 SCALE: NTS

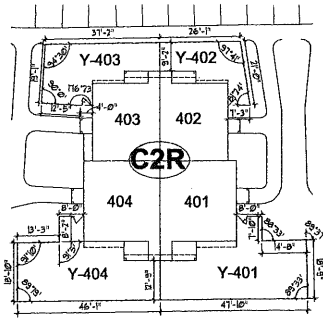


4 FENCE PLAN - BUILDING 4  
CPR-0.2 SCALE: NTS

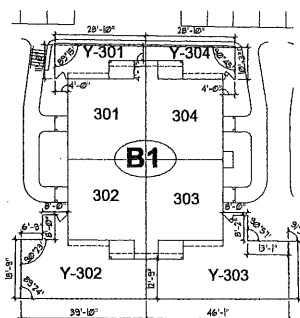


3 FENCE PLAN - BUILDING 3  
CPR-0.2 SCALE: NTS

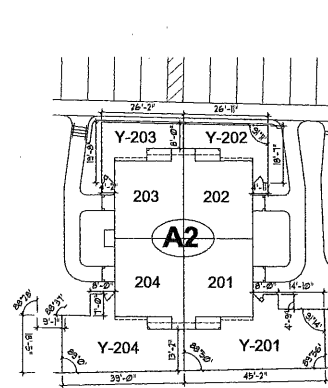


2 FENCE PLAN - BUILDING 2  
CPR-0.2 SCALE: NTS

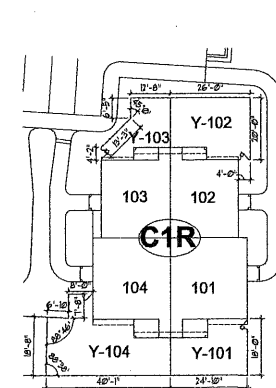


1 FENCE PLAN - BUILDING 1  
CPR-0.2 SCALE: NTS

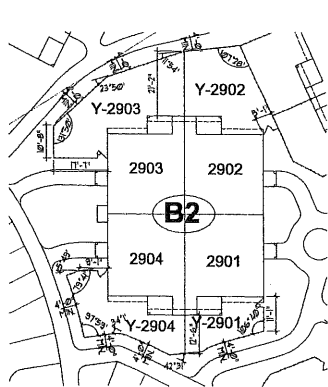


10 FENCE PLAN - BUILDING 29  
CPR-0.2 SCALE: NTS

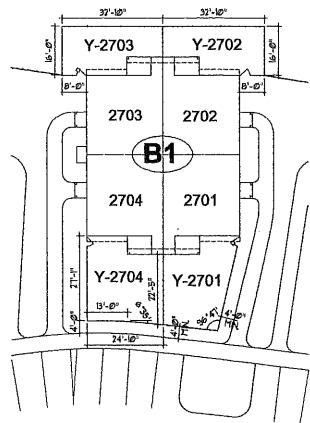


9 FENCE PLAN - BUILDING 27  
CPR-0.2 SCALE: NTS

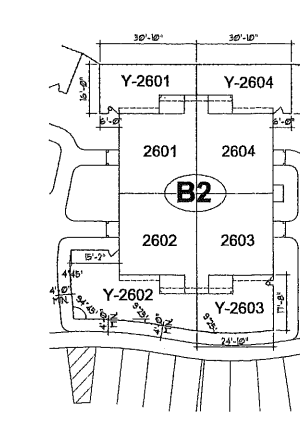

8 FENCE PLAN - BUILDING 26  
CPR-0.2 SCALE: NTS

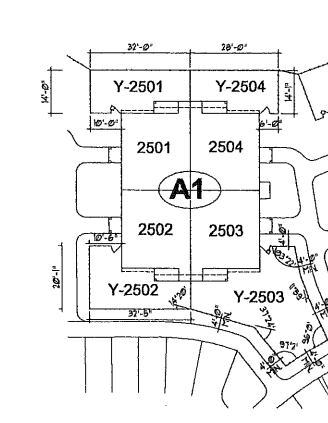

7 FENCE PLAN - BUILDING 25  
CPR-0.2 SCALE: NTS

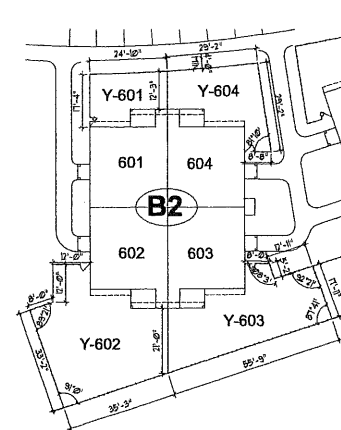

6 FENCE PLAN - BUILDING 6  
CPR-0.2 SCALE: NTS

THIS CONDOMINIUM MAP MAY CONTAIN FLOOR PLANS AND ELEVATIONS OF APARTMENT TYPES THAT ARE NOT INCLUDED IN THIS PROJECT. PLEASE REFER TO THE SITE PLAN TO DETERMINE THE APARTMENT TYPES THAT ARE INCLUDED IN THIS PROJECT.

THE ELEVATIONS AND FLOOR PLANS SHOWN ARE FAIR REPRESENTATION TO ASSIST THE PUBLIC IN VISUALIZING THE CONDOMINIUM UNITS AND MAY NOT BE ACCURATELY DEPICTED. THE DEVELOPER, ITS AGENTS, ASSOCIATE COMPANIES AND SUPPLIERS RESERVE THE RIGHT TO MODIFY PLANS, SPECIFICATIONS AND FEATURES WITHOUT PRIOR NOTICE OR OBLIGATION. FOR SPECIFIC INFORMATION ON ANY OF THE ABOVE ELEMENTS, PLEASE CONTACT CASTLE & COOKE WAIKOLOA, LLC.

**METHOD OF COMPUTING FLOOR AREA**  
THE FLOOR AREA OF THE APARTMENT OR UNIT SHALL BE COMPUTED AND REPORTED IN THE DECLARATION AND COMMISSIONS PUBLIC REPORT AS NET LIVING AREA. THE LIVING AREA OF THE ENCLOSED PORTION OF THE APARTMENT SHALL BE MEASURED FROM THE INTERIOR SURFACES OF THE APARTMENT PERIMETER WALLS. AREAS OF LANAI OR BALCONY, WHICH ARE CONSIDERED AS PART OF THE APARTMENT, SHALL BE COMPUTED AND REPORTED SEPARATE FROM THE ENCLOSED APARTMENT AREA.  
(REF. 6/10/01 (AUTH. HRS 6ECT, 614A-45) (IMP. 6ECT, 614A-1K2))




**Design Partners Incorporated**  
Architectural  
Mechanical  
Electrical Design



Revision Number/Description

**Makana Kai**  
At Wehilani  
PHASE I  
WAIKOLOA, SOUTH KOHALA, HAWAII  
CASTLE & COOKE WAIKOLOA, LLC




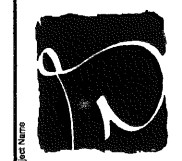


Drawing Title: FENCING PLANS

Project Number: 63633-07 Date: JUNE 8, 2006  
Drawn: CAD Checked: CA Designed: LT/CS/MS

Drawing Number: CPR-0.2

Sheet No. of

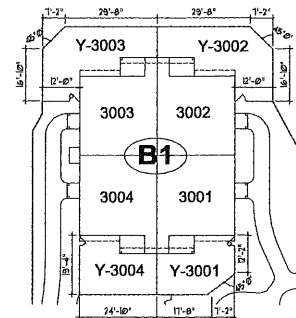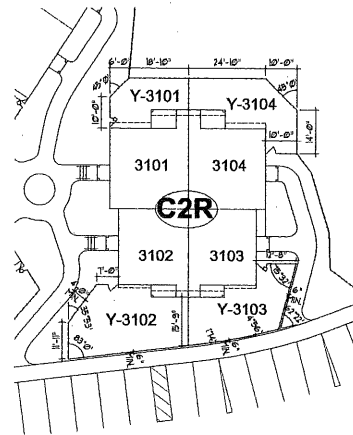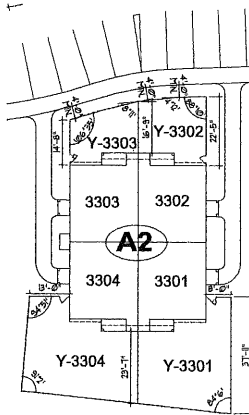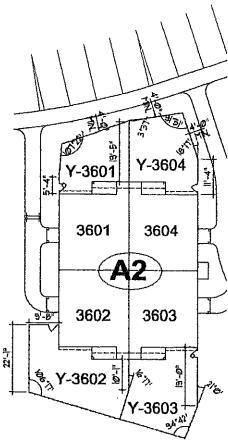

5 FENCE PLAN - BUILDING 36  
CPR-0.3 SCALE: NTS

4 FENCE PLAN - BUILDING 35  
CPR-0.3 SCALE: NTS

3 FENCE PLAN - BUILDING 33  
CPR-0.3 SCALE: NTS


2 FENCE PLAN - BUILDING 31  
CPR-0.3 SCALE: NTS

1 FENCE PLAN - BUILDING 30  
CPR-0.3 SCALE: NTS


THIS CONDOMINIUM MAP MAY CONTAIN FLOOR PLANS AND ELEVATIONS OF APARTMENT TYPES THAT ARE NOT INCLUDED IN THIS PROJECT. PLEASE REFER TO THE SITE PLAN TO DETERMINE THE APARTMENT TYPES THAT ARE INCLUDED IN THIS PROJECT.

THE ELEVATIONS AND FLOOR PLANS SHOWN ARE FAIR REPRESENTATION TO ASSIST THE PUBLIC IN VISUALIZING THE CONDOMINIUM UNITS AND MAY NOT BE ACCURATELY DEPICTED. THE DEVELOPER, ITS AGENTS, ASSOCIATE COMPANIES AND SUPPLIERS RESERVE THE RIGHT TO MODIFY PLANS, SPECIFICATIONS AND FEATURES WITHOUT PRIOR NOTICE OR OBLIGATION. FOR SPECIFIC INFORMATION ON ANY OF THE ABOVE ELEMENTS, PLEASE CONTACT CASTLE & COOKE WAIKOLOA, LLC.


**METHOD OF COMPUTING FLOOR AREA**  
THE FLOOR AREA OF THE APARTMENT OR UNIT SHALL BE COMPUTED AND REPORTED IN THE DECLARATION AND COMMISSION'S PUBLIC REPORT AS NET LIVING AREA. THE LIVING AREA OF THE ENCLOSED PORTION OF THE APARTMENT SHALL BE MEASURED FROM THE INTERIOR SURFACES OF THE APARTMENT PERIMETER WALLS. AREAS OF LANAI OR BALCONY, WHICH ARE CONSIDERED AS PART OF THE APARTMENT, SHALL BE COMPUTED AND REPORTED SEPARATE FROM THE ENCLOSED APARTMENT AREA.  
(BFP, 6/12/01) (AUTH: HRS SECT. 514A-45) (IMP. SECT. 514A-11(2))

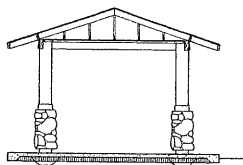

8 PAVILION SECTION  
CPR-0.3 SCALE: NTS

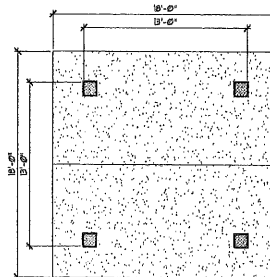

7 PAVILION FLOOR PLAN  
CPR-0.3 SCALE: NTS

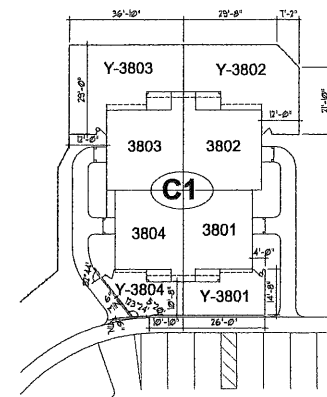

6 FENCE PLAN - BUILDING 38  
CPR-0.3 SCALE: NTS




**Design Partners Incorporated**  
Architects  
Planning  
Interior Design



APR 30, 2025  
The work was prepared by me or under my direct supervision and I am a duly licensed professional engineer in the State of Hawaii.

Revision Number/Description

**Makana Kai**  
At Wehiani  
PHASE I  
WAIKOLOA, SOUTH KOHALA, HAWAII  
CASTLE & COOKE WAIKOLOA, LLC

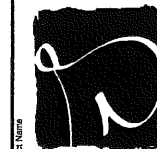

Project Name: Makana Kai At Wehiani Phase I  
Drawing Title: FENCING PLANS PAVILION FLOOR PLAN 1 SECTION

Project Number: 250333-01 Date: JUNE 8, 2024  
Drawn: [ ] Checked: [ ] Designed: [ ]  
CAD: [ ] CB: [ ] LT/C&MG

Drawing Number: CPR-0.3

Sheet No. of





**Design Partners Incorporated**  
 Architects  
 Planning  
 Interior Design

REGISTERED PROFESSIONAL ARCHITECT  
 LICENSE NO. 3422  
 APR 30, 2008  
 HAWAII  
 The work was prepared by me or under my direct supervision and I am a duly licensed professional architect in the State of Hawaii.


Revision Number/Description

**Makana Kai**  
 At Wehilani  
 PHASE I  
 WAIKOLOA, SOUTH KOHALA, HAWAII  
 CASTLE & COOKE WAIKOLOA, LLC




Project Name  
 Drawing Title  
 BUILDING TYPE 'A'  
 EXTERIOR ELEVATIONS  
 Project Number  
 Date  
 07033-071  
 JUNE 8, 2004  
 Drawn  
 Checked  
 CAD  
 CCB  
 Designed  
 LT/CAP/BS


Drawing Number  
**CPR-1.1**  
 Sheet No. of

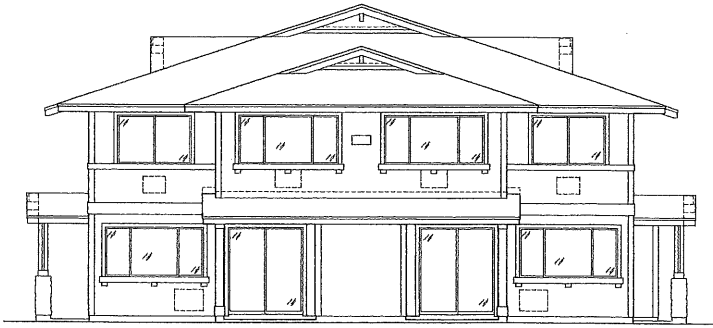

RIGHT ELEVATION - BUILDING 'A'

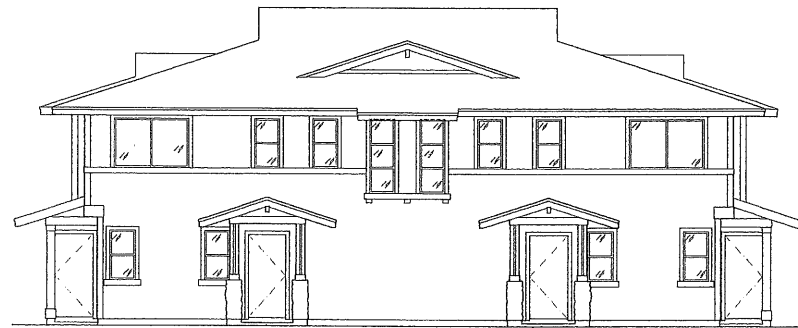


FRONT ELEVATION - BUILDING 'A'

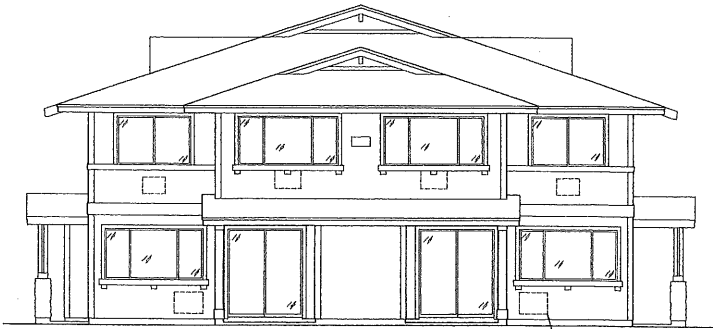

LEFT ELEVATION - BUILDING 'A'

A/C BLOCKOUT (TYP)

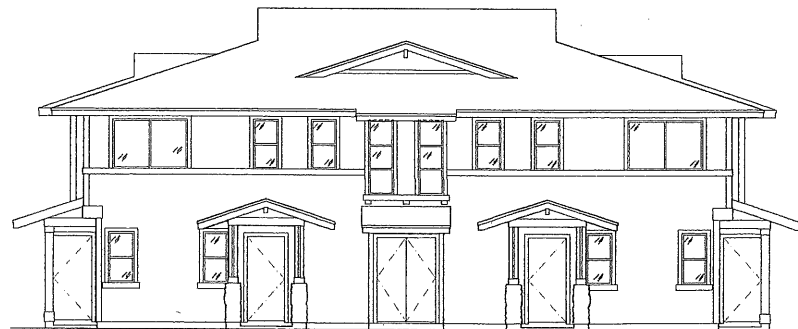

REAR ELEVATION - BUILDING 'A'

THIS CONDOMINIUM MAP MAY CONTAIN FLOOR PLANS AND ELEVATIONS OF APARTMENT TYPES THAT ARE NOT INCLUDED IN THIS PROJECT. PLEASE REFER TO THE SITE PLAN TO DETERMINE THE APARTMENT TYPES THAT ARE INCLUDED IN THIS PROJECT.

THE ELEVATIONS AND FLOOR PLANS SHOWN ARE FAIR REPRESENTATION TO ASSIST THE PUBLIC IN VISUALIZING THE CONDOMINIUM UNITS AND MAY NOT BE ACCURATELY DEPICTED. THE DEVELOPER, ITS AGENTS, ASSOCIATE COMPANIES AND SUPPLIERS RESERVE THE RIGHT TO MODIFY PLANS, SPECIFICATIONS AND FEATURES WITHOUT PRIOR NOTICE OR OBLIGATION. FOR SPECIFIC INFORMATION ON ANY OF THE ABOVE ELEMENTS, PLEASE CONTACT CASTLE & COOKE WAIKOLOA, LLC.

**METHOD OF COMPUTING FLOOR AREA**  
 THE FLOOR AREA OF THE APARTMENT OR UNIT SHALL BE COMPUTED AND REPORTED IN THE DECLARATION AND COMMONS PUBLIC REPORT AS NET LIVING AREA. THE LIVING AREA OF THE ENCLOSED PORTION OF THE APARTMENT SHALL BE MEASURED FROM THE INTERIOR SURFACES OF THE APARTMENT PERIMETER WALLS, AREAS OF LANAI OR BALCONY WHICH ARE CONSIDERED AS PART OF THE APARTMENT, SHALL BE COMPUTED AND REPORTED SEPARATE FROM THE ENCLOSED APARTMENT AREA.  
 (EFF. 6/12/81) (AUTH: HRS BECT. 514A-4B) (IMP. BECT. 514A-1K2)

EXTERIOR ELEVATIONS - BUILDING TYPE 'A'  
 SCALE: NTS


Revision Number/Description

**Makana Kai**  
 At Wehiani  
 PHASE I  
 WAIKOLOA SOUTH KOHALA, HAWAII  
 CASTLE & COOKE WAIKOLOA, LLC




Project Name: \_\_\_\_\_  
 Drawing Title: \_\_\_\_\_  
 Project Number: 62033-01 Date: JUNE 9, 2025  
 Drawn: \_\_\_\_\_ Checked: \_\_\_\_\_ C64  
 CAD: \_\_\_\_\_ Disigned: \_\_\_\_\_ LT/C&C


Drawing Number: \_\_\_\_\_  
**CPR-1.2**  
 Sheet No. of

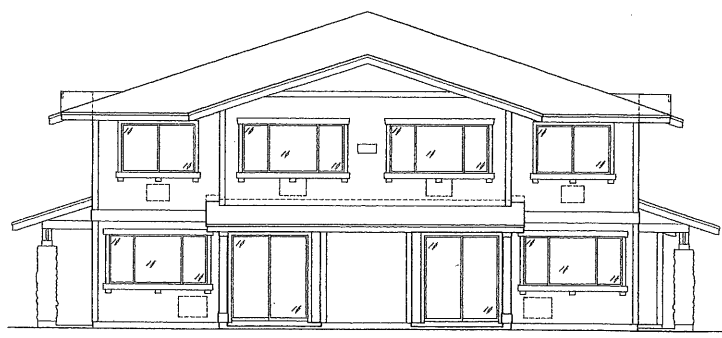

RIGHT ELEVATION - BUILDING 'A2'

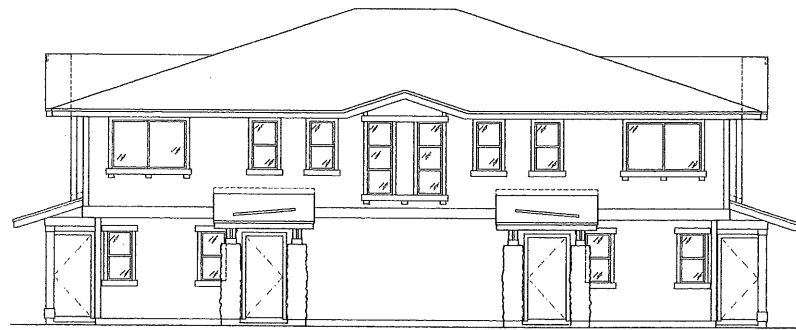

FRONT ELEVATION - BUILDING 'A2'

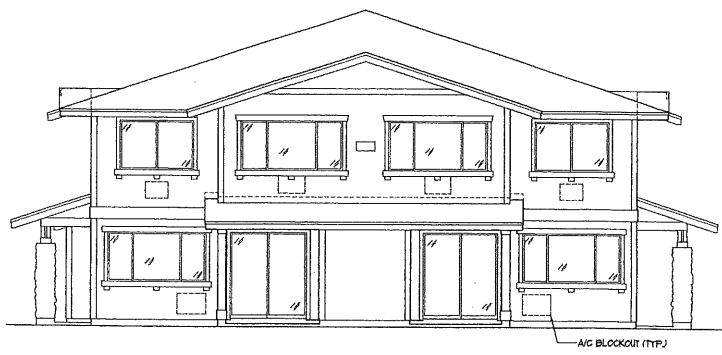

LEFT ELEVATION - BUILDING 'A2'




REAR ELEVATION - BUILDING 'A2'


THIS CONDOMINIUM MAP MAY CONTAIN FLOOR PLANS AND ELEVATIONS OF APARTMENT TYPES THAT ARE NOT INCLUDED IN THIS PROJECT. PLEASE REFER TO THE SITE PLAN TO DETERMINE THE APARTMENT TYPES THAT ARE INCLUDED IN THIS PROJECT.

THE ELEVATIONS AND FLOOR PLANS SHOWN ARE FAIR REPRESENTATION TO ASSIST THE PUBLIC IN VISUALIZING THE CONDOMINIUM UNITS AND MAY NOT BE ACCURATELY DEPICTED. THE DEVELOPER, ITS AGENTS, ASSOCIATE COMPANIES AND SUPPLIERS RESERVE THE RIGHT TO MODIFY PLANS, SPECIFICATIONS AND FEATURES WITHOUT PRIOR NOTICE OR OBLIGATION. FOR SPECIFIC INFORMATION ON ANY OF THE ABOVE ELEMENTS, PLEASE CONTACT CASTLE & COOKE WAIKOLOA LLC.

METHOD OF COMPUTING FLOOR AREA  
 THE FLOOR AREA OF THE APARTMENT OR UNIT SHALL BE COMPUTED AND REPORTED IN THE DECLARATION AND COMMISSION'S PUBLIC REPORT AS NET LIVING AREA. THE LIVING AREA OF THE ENCLOSED PORTION OF THE APARTMENT SHALL BE MEASURED FROM THE INTERIOR SURFACES OF THE APARTMENT PERIMETER WALLS, AREAS OF LANAI OR BALCONY WHICH ARE CONSIDERED AS PART OF THE APARTMENT AREA, SHALL BE COMPUTED AND REPORTED SEPARATE FROM THE ENCLOSED APARTMENT AREA.  
 (REF. 6/12/81) (AUTH: HRS SECT. 514A-48) (11/81) SECT. 514A-1(2.2)

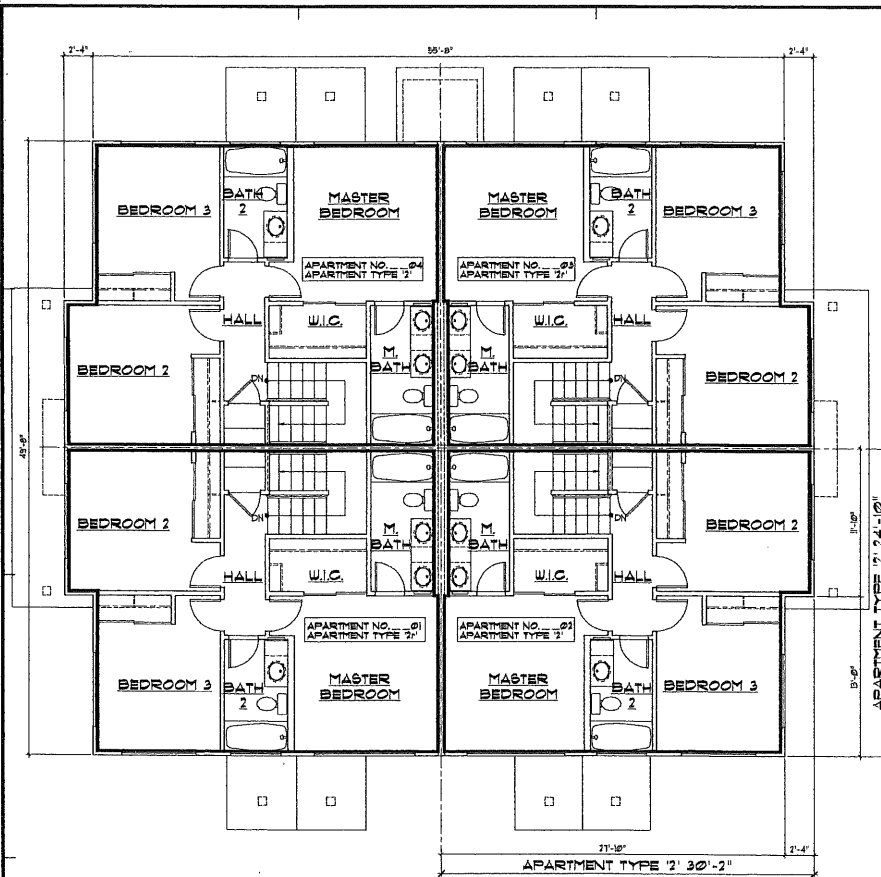

2 SECOND FLOOR PLAN - BUILDING TYPE 'B'  
SCALE: NTS

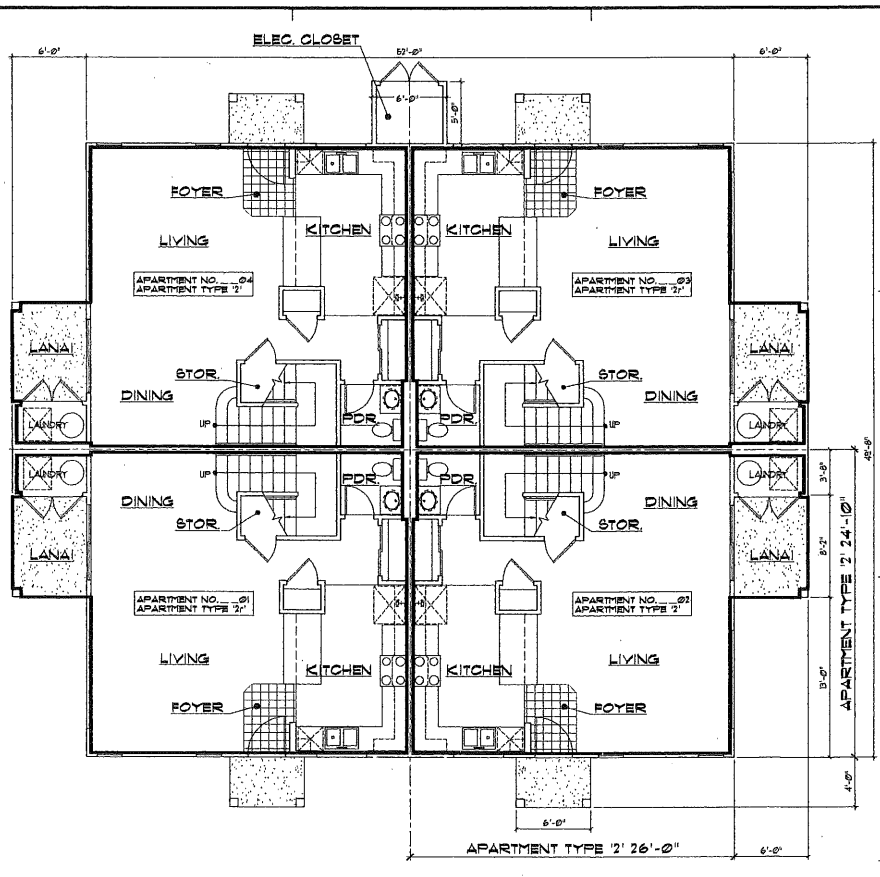

1 FIRST FLOOR PLAN - BUILDING TYPE 'B'  
SCALE: NTS

THIS CONDOMINIUM MAP MAY CONTAIN FLOOR PLANS AND ELEVATIONS OF APARTMENT TYPES THAT ARE NOT INCLUDED IN THIS PROJECT. PLEASE REFER TO THE SITE PLAN TO DETERMINE THE APARTMENT TYPES THAT ARE INCLUDED IN THIS PROJECT.

THE ELEVATIONS AND FLOOR PLANS SHOWN ARE FAIR REPRESENTATION TO ASSIST THE PUBLIC IN VISUALIZING THE CONDOMINIUM UNITS AND MAY NOT BE ACCURATELY DEPICTED. THE DEVELOPER, ITS AGENTS, ASSOCIATE COMPANIES AND SUPPLIERS RESERVE THE RIGHT TO MODIFY PLANS, SPECIFICATIONS AND FEATURES WITHOUT PRIOR NOTICE OR OBLIGATION. FOR SPECIFIC INFORMATION ON ANY OF THE ABOVE ELEMENTS, PLEASE CONTACT CASTLE & COOKE WAIKOLOA, LLC.

**METHOD OF COMPUTING FLOOR AREA**  
 THE FLOOR AREA OF THE APARTMENT OR UNIT SHALL BE COMPUTED AND REPORTED IN THE DECLARATION AND CONTRIBUTOR'S PUBLIC REPORT AS NET LIVING AREA. THE LIVING AREA OF THE ENCLOSED PORTION OF THE APARTMENT SHALL BE MEASURED FROM THE INTERIOR SURFACES OF THE APARTMENT PERIMETER WALLS. AREAS OF LANAI OR BALCONY, WHICH ARE CONSIDERED AS PART OF THE APARTMENT, SHALL BE COMPUTED AND REPORTED SEPARATE FROM THE ENCLOSED APARTMENT AREA.  
 (CPR: 6/13/07 (AUTH: HRB SECT. 514A-45) (MIP: SECT. 514A-112))

CPR AREA CALCULATIONS

UNIT 2 / 2R	
LIVING AREA:	
LOWER FLOOR	613 SF
UPPER FLOOR	632 SF
SUBTOTAL	1245 SF
LANDRY	11 SF
LANAI	48 SF
TOTAL	1304 SF




Design Partners Incorporated  
 Architects  
 Planning  
 Interior Design

LEEDS  
 GREEN  
 BUILDING  
 CERTIFIED  
 No. 4272

APR 30, 2008  
 COMMERCIAL USE ONLY

This work was prepared for the use of a particular project and is not to be used for any other project without the written consent of the architect.


**Makana Kai**  
 At *Wehilani*  
 PHASE I  
 WAIKOLOA, SOUTH KOHALA, HAWAII  
 CASTLE & COOKE WAIKOLOA, LLC

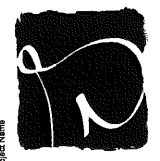

Project Name: Makana Kai At Wehilani Phase I  
 Drawing Title: BUILDING TYPE 'B' FLOOR PLANS  
 Project Number: 03033-07  
 Date: JUNE 8, 2008  
 Drawn: CAD  
 Checked: CB  
 Designed: LT,CAMG  
 Drawing Number: CPR-2.0  
 Sheet No. of




RIGHT ELEVATION - BUILDING 'B1'

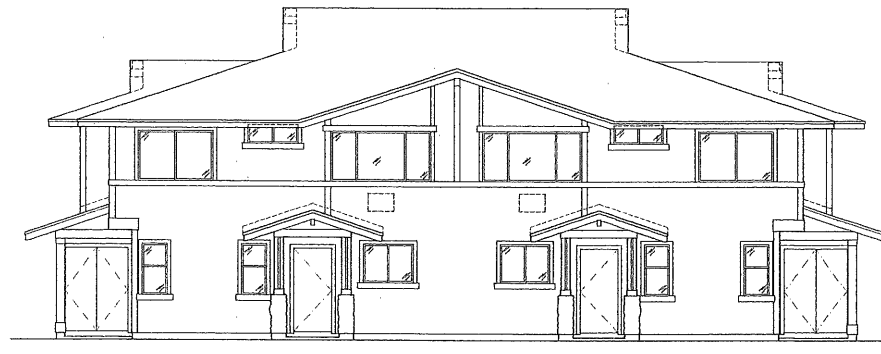

FRONT ELEVATION - BUILDING 'B1'



LEFT ELEVATION - BUILDING 'B1'

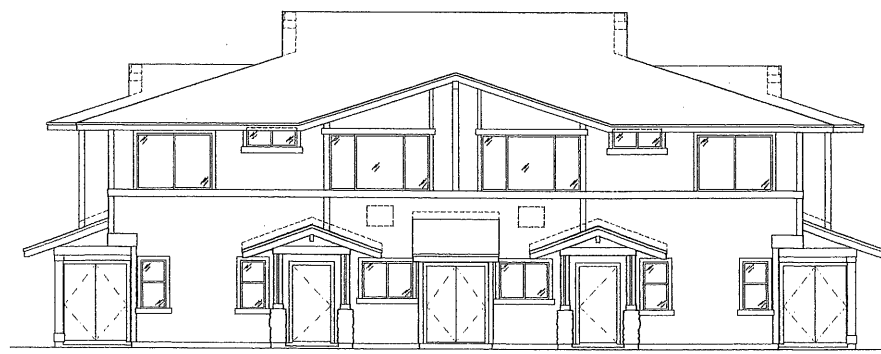

REAR ELEVATION - BUILDING 'B1'

THIS CONDOMINIUM MAP MAY CONTAIN FLOOR PLANS AND ELEVATIONS OF APARTMENT TYPES THAT ARE NOT INCLUDED IN THIS PROJECT. PLEASE REFER TO THE SITE PLAN TO DETERMINE THE APARTMENT TYPES THAT ARE INCLUDED IN THIS PROJECT.

THE ELEVATIONS AND FLOOR PLANS SHOWN ARE FAIR REPRESENTATION TO ASSIST THE PUBLIC IN VISUALIZING THE CONDOMINIUM UNITS AND MAY NOT BE ACCURATELY DEPICTED. THE DEVELOPER, ITS AGENTS, ASSOCIATE COMPANIES AND SUPPLIERS RESERVE THE RIGHT TO MODIFY PLANS, SPECIFICATIONS AND FEATURES WITHOUT PRIOR NOTICE OR OBLIGATION. FOR SPECIFIC INFORMATION ON ANY OF THE ABOVE ELEMENTS, PLEASE CONTACT CASTLE & COOKE WAIKOLOA, LLC.

**METHOD OF COMPUTING FLOOR AREA**

THE FLOOR AREA OF THE APARTMENT OR UNIT SHALL BE COMPUTED AND REPORTED IN THE DECLARATION AND COMMISSION'S PUBLIC REPORT AS NET LIVING AREA. THE LIVING AREA OF THE ENCLOSED PORTION OF THE APARTMENT SHALL BE MEASURED FROM THE INTERIOR SURFACES OF THE APARTMENT PERIMETER WALLS. AREAS OF LANAI OR BALCONY, WHICH ARE CONSIDERED AS PART OF THE APARTMENT, SHALL BE COMPUTED AND REPORTED SEPARATE FROM THE ENCLOSED APARTMENT AREA. (EFF. 6/12/01) (AUTH. HRS SECT. 514A-16) (IMP), SECT. 514A-1(2).

EXTERIOR ELEVATIONS - BUILDING TYPE 'B1'  
SCALE: NTS



APR 30, 2008  
EXPIRES 04/30/2011  
THIS SEAL AND SIGNATURE ARE VALID FOR THE EXERCISE OF PROFESSIONAL SERVICES ONLY FOR THE STATE OF HAWAII.

Revision Number/Description


**Makana Kai**  
At **Wehiani**  
PHASE I  
WAIKOLOA, SOUTH KOHALA, HAWAII  
CASTLE & COOKE WAIKOLOA, LLC




Project Name

Drawing Title: BUILDING TYPE 'B1' EXTERIOR ELEVATIONS

Project Number: 012033-07 Date: JAN 8, 2008  
Drawn: CAD Checked: CA Designed: LTC/MJC


Drawing Number: CPR-2.1  
Sheet No. of

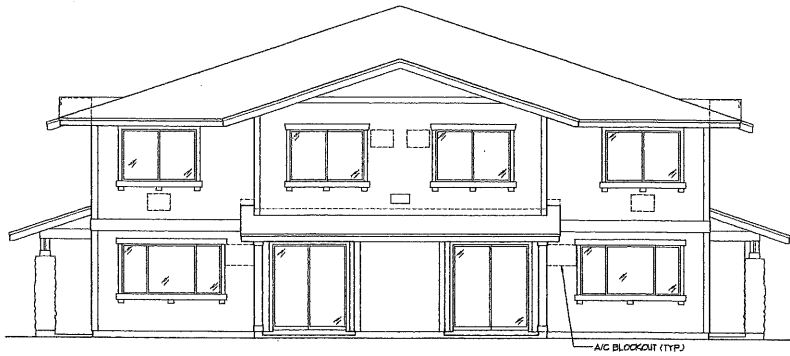

RIGHT ELEVATION - BUILDING 'B2'



FRONT ELEVATION - BUILDING 'B2'

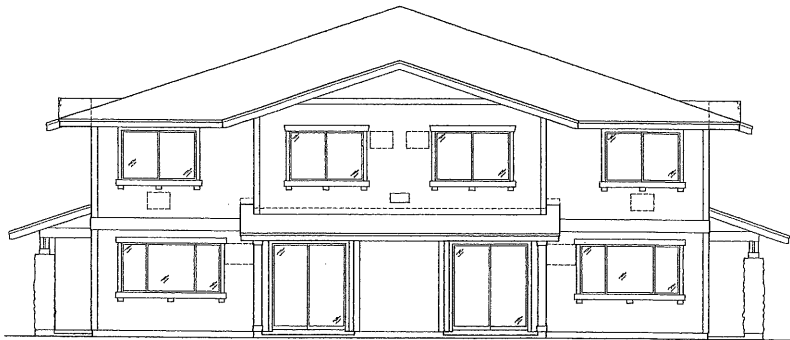

LEFT ELEVATION - BUILDING 'B2'



REAR ELEVATION - BUILDING 'B2'

THIS CONDOMINIUM MAP MAY CONTAIN FLOOR PLANS AND ELEVATIONS OF APARTMENT TYPES THAT ARE NOT INCLUDED IN THIS PROJECT. PLEASE REFER TO THE SITE PLAN TO DETERMINE THE APARTMENT TYPES THAT ARE INCLUDED IN THIS PROJECT.

THE ELEVATIONS AND FLOOR PLANS SHOWN ARE FAIR REPRESENTATION TO ASSIST THE PUBLIC IN VISUALIZING THE CONDOMINIUM UNITS AND MAY NOT BE ACCURATELY DEPICTED. THE DEVELOPER, ITS AGENTS, ASSOCIATE COMPANIES AND SUPPLIERS RESERVE THE RIGHT TO MODIFY PLANS, SPECIFICATIONS AND FEATURES WITHOUT PRIOR NOTICE OR OBLIGATION. FOR SPECIFIC INFORMATION ON ANY OF THE ABOVE ELEMENTS, PLEASE CONTACT CASTLE & COOKE WAIKOLOA, LLC.

**METHOD OF COMPUTING FLOOR AREA**  
 THE FLOOR AREA OF THE APARTMENT OR UNIT SHALL BE COMPUTED AND REPORTED IN THE DECLARATION AND COMMISSION'S PUBLIC REPORT AS NET LIVING AREA. THE LIVING AREA OF THE ENCLOSED PORTION OF THE APARTMENT SHALL BE MEASURED FROM THE INTERIOR SURFACES OF THE APARTMENT PERIMETER WALLS, AREAS OF LANAI OR BALCONY, WHICH ARE CONSIDERED AS PART OF THE APARTMENT, SHALL BE COMPUTED AND REPORTED SEPARATE FROM THE ENCLOSED APARTMENT AREA.  
 (B.P. 6/17/81) (AUTH: HRS SECT. 514A-45) (IMP), SECT. 514A-1(2))

EXTERIOR ELEVATIONS - BUILDING TYPE 'B2'  
 SCALE: NTS




Revision Number/Description

**Makana Kai**  
 At Wehilani  
 PHASE I  
 WAIKOLOA, SOUTH KOHALA, HAWAII  
 CASTLE & COOKE WAIKOLOA, LLC




Drawing Title: BUILDING TYPE 'B2' EXTERIOR ELEVATIONS  
 Project Number: 07033-07 Date: JUNE 0, 2008  
 Drawn: CAD Checked: CS Designed: LT/CSP  
 Drawing Number: CPR-2.2  
 Sheet No. of




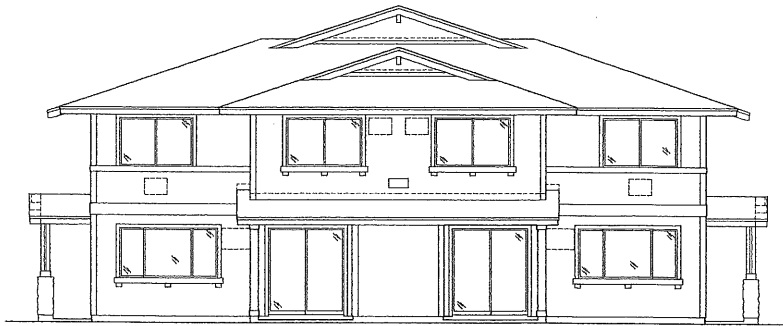


RIGHT ELEVATION - BUILDING 'C1'

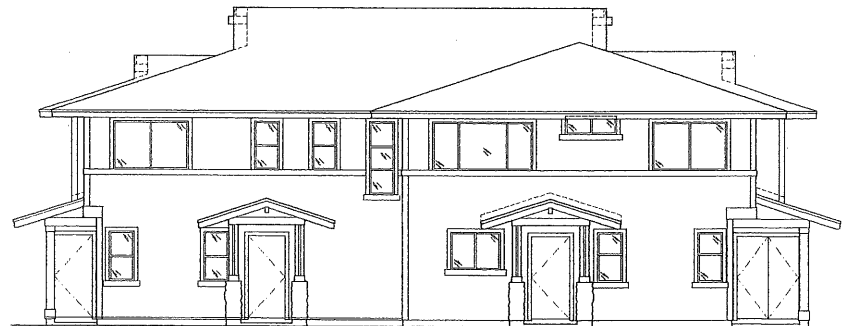

FRONT ELEVATION - BUILDING 'C1'

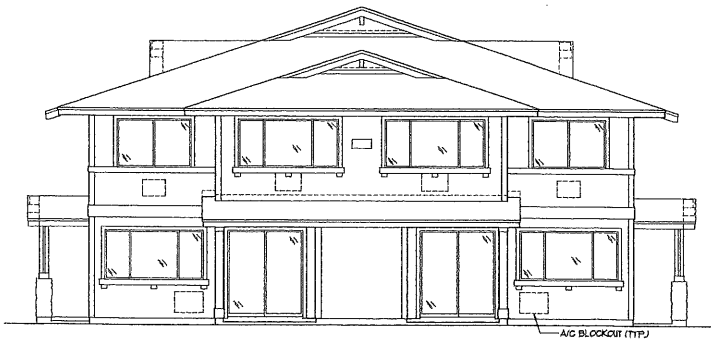

LEFT ELEVATION - BUILDING 'C1'

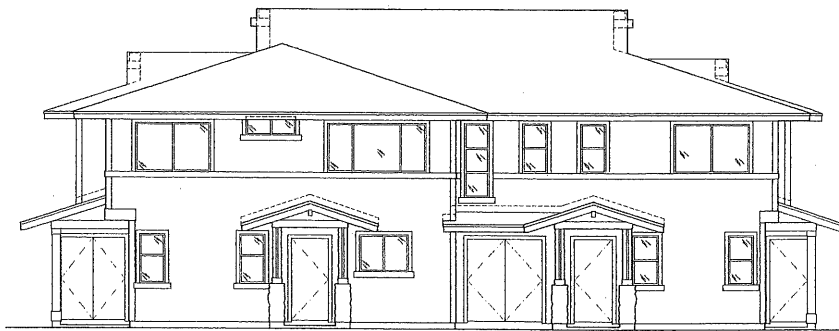

REAR ELEVATION - BUILDING 'C1'

THIS CONDOMINIUM MAP MAY CONTAIN FLOOR PLANS AND ELEVATIONS OF APARTMENT TYPES THAT ARE NOT INCLUDED IN THIS PROJECT. PLEASE REFER TO THE SITE PLAN TO DETERMINE THE APARTMENT TYPES THAT ARE INCLUDED IN THIS PROJECT.

THE ELEVATIONS AND FLOOR PLANS SHOWN ARE FAIR REPRESENTATION TO ASSIST THE PUBLIC IN VISUALIZING THE CONDOMINIUM UNITS AND MAY NOT BE ACCURATELY DEPICTED. THE DEVELOPER, ITS AGENTS, ASSOCIATE COMPANIES AND SUPPLIERS RESERVE THE RIGHT TO MODIFY PLANS, SPECIFICATIONS AND FEATURES WITHOUT PRIOR NOTICE OR OBLIGATION. FOR SPECIFIC INFORMATION ON ANY OF THE ABOVE ELEMENTS, PLEASE CONTACT CASTLE & COOKE WAIKOLOA LLC.

**METHOD OF COMPUTING FLOOR AREA**  
 THE FLOOR AREA OF THE APARTMENT OR UNIT SHALL BE COMPUTED AND REPORTED IN THE DECLARATION AND COMMISSION'S PUBLIC REPORT AS NET LIVING AREA. THE LIVING AREA OF THE ENCLOSED PORTION OF THE APARTMENT SHALL BE MEASURED FROM THE INTERIOR SURFACES OF THE APARTMENT PERIMETER WALLS, AREAS OF LANAI OR BALCONY, WHICH ARE CONSIDERED AS PART OF THE APARTMENT, SHALL BE COMPUTED AND REPORTED SEPARATE FROM THE ENCLOSED APARTMENT AREA.  
 (REF. 6/17/89 (AUTH. HR9 6ECT. 514A-45) (IMP. 6ECT. 514A-112))

1  
 CFR-31  
 EXTERIOR ELEVATIONS - BUILDING TYPE 'C1'  
 SCALE: NTS



Revision Number/Description

**Makana Kai**  
 At Wehilani  
 PHASE I  
 WAIKOLOA, SOUTH KOHALA, HAWAII  
 CASTLE & COOKE WAIKOLOA, LLC



Drawing Title		BUILDING TYPE 'C1' EXTERIOR ELEVATIONS	
Project Number	Date	Drawn	Checked
03033-07	JUNE 8, 2004	CAD	CS
Designed	LTG/MS		

Drawing Number  
**CPR-3.1**  
 Sheet No. of





**Design Partners Incorporated**  
Architects  
Planners  
Interior Design



APR 30, 2008  
Expiration Date of License  
This work was prepared by me or under my direct supervision and I am a duly licensed professional engineer in the State of Hawaii.



Revision Number/Description

**Makana Kai**  
At **Wehiani**  
PHASE I  
WAIKOLOA, SOUTH KOHALA, HAWAII  
CASTLE & COOKE WAIKOLOA, LLC





Project Title: BUILDING TYPE 'CIR' EXTERIOR ELEVATIONS  
Project Number: 03033-02 Date: JUNE 8, 2008  
Drawn: CAD Checked: CS Design: LT/CS/TK

Drawing Number: **CPR-3.4**  
Sheet No. of

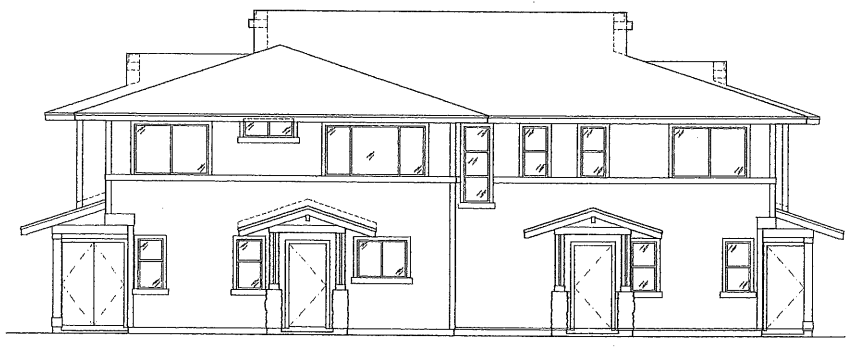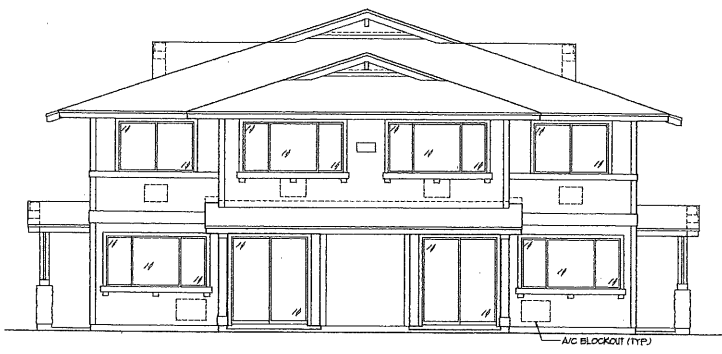

RIGHT ELEVATION - BUILDING 'CIR'

FRONT ELEVATION - BUILDING 'CIR'

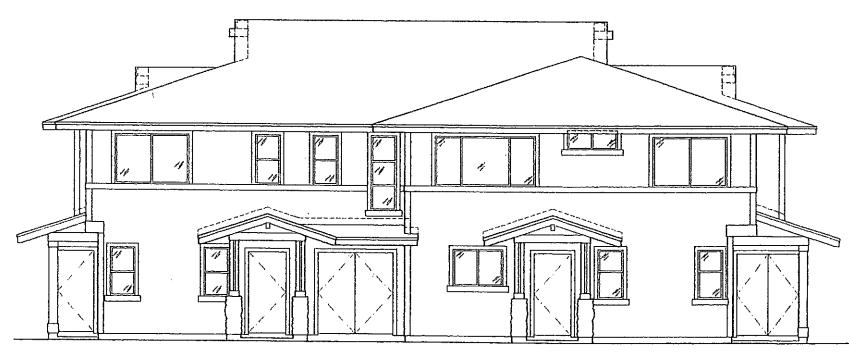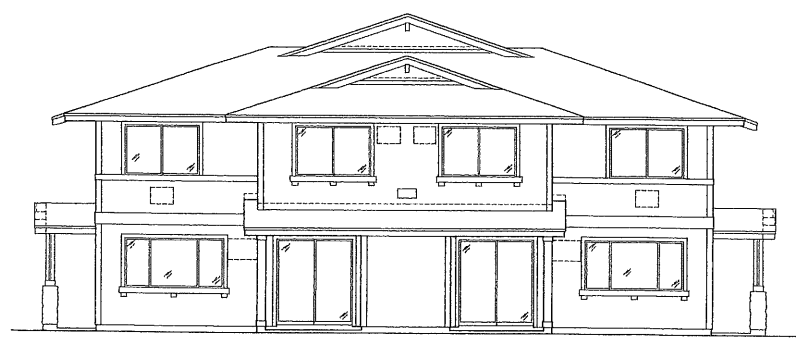

LEFT ELEVATION - BUILDING 'CIR'


REAR ELEVATION - BUILDING 'CIR'

THIS CONDOMINIUM MAP MAY CONTAIN FLOOR PLANS AND ELEVATIONS OF APARTMENT TYPES THAT ARE NOT INCLUDED IN THIS PROJECT. PLEASE REFER TO THE SITE PLAN TO DETERMINE THE APARTMENT TYPES THAT ARE INCLUDED IN THIS PROJECT.

THE ELEVATIONS AND FLOOR PLANS SHOWN ARE FAIR REPRESENTATION TO ASSIST THE PUBLIC IN VISUALIZING THE CONDOMINIUM UNITS AND MAY NOT BE ACCURATELY DEPICTED. THE DEVELOPER, ITS AGENTS, ASSOCIATE COMPANIES AND SUPPLIERS RESERVE THE RIGHT TO MODIFY PLANS, SPECIFICATIONS AND FEATURES WITHOUT PRIOR NOTICE OR OBLIGATION. FOR SPECIFIC INFORMATION ON ANY OF THE ABOVE ELEMENTS, PLEASE CONTACT CASTLE & COOKE WAIKOLOA LLC.

**METHOD OF COMPUTING FLOOR AREA**  
THE FLOOR AREA OF THE APARTMENT OR UNIT SHALL BE COMPUTED AND REPORTED IN THE DECLARATION AND COMMISSION'S PUBLIC REPORT AS NET LIVING AREA. THE LIVING AREA OF THE ENCLOSED PORTION OF THE APARTMENT SHALL BE MEASURED FROM THE INTERIOR SURFACES OF THE APARTMENT PERIMETER WALLS. AREAS OF LANAI OR BALCONY WHICH ARE CONSIDERED AS PART OF THE APARTMENT, SHALL BE COMPUTED AND REPORTED SEPARATE FROM THE ENCLOSED APARTMENT AREA. (EFF. 6/7/8) (AUTH. HRS SECT. 514A-45) (IMP. SECT. 514A-102)


1  
CPR-3.4  
SCALE: NTS  
**EXTERIOR ELEVATIONS - BUILDING TYPE 'CIR'**

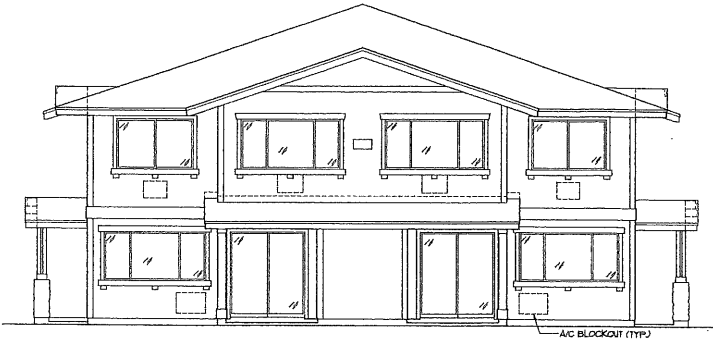


RIGHT ELEVATION - BUILDING 'C2R'



FRONT ELEVATION - BUILDING 'C2R'

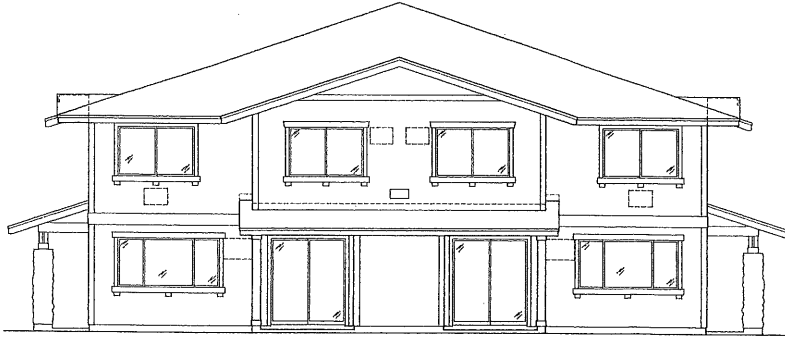

LEFT ELEVATION - BUILDING 'C2R'

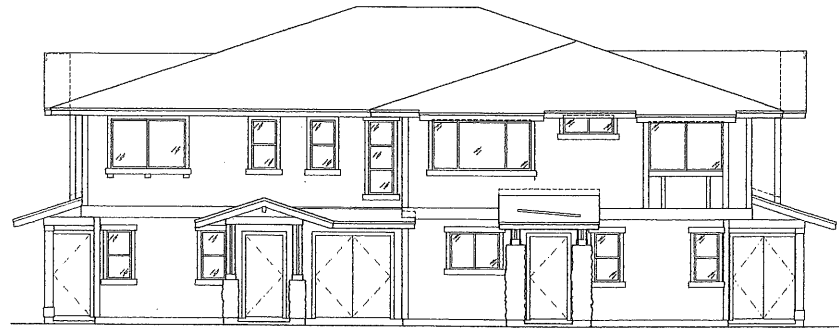

REAR ELEVATION - BUILDING 'C2R'

THIS CONDOMINIUM MAP MAY CONTAIN FLOOR PLANS AND ELEVATIONS OF APARTMENT TYPES THAT ARE NOT INCLUDED IN THIS PROJECT. PLEASE REFER TO THE SITE PLAN TO DETERMINE THE APARTMENT TYPES THAT ARE INCLUDED IN THIS PROJECT.

THE ELEVATIONS AND FLOOR PLANS SHOWN ARE FAIR REPRESENTATION TO ASSIST THE PUBLIC IN VISUALIZING THE CONDOMINIUM UNITS AND THAT MAY NOT BE ACCURATELY DEPICTED. THE DEVELOPER, ITS AGENTS, ASSOCIATE COMPANIES AND SUPPLIERS RESERVE THE RIGHT TO MODIFY PLANS, SPECIFICATIONS AND FEATURES WITHOUT PRIOR NOTICE OR OBLIGATION. FOR SPECIFIC INFORMATION ON ANY OF THE ABOVE ELEMENTS, PLEASE CONTACT CASTLE & COOKE WAIKOLOA LLC.

**METHOD OF COMPUTING FLOOR AREA**  
 THE FLOOR AREA OF THE APARTMENT OR UNIT SHALL BE COMPUTED AND REPORTED IN THE DECLARATION AND COMMONOWNERS PUBLIC REPORT AS NET LIVING AREA. THE LIVING AREA OF THE ENCLOSED PORTION OF THE APARTMENT SHALL BE MEASURED FROM THE INTERIOR SURFACES OF THE APARTMENT PERIMETER WALLS, AREAS OF LANAI OR BALCONY, WHICH ARE CONSIDERED AS PART OF THE APARTMENT, SHALL BE COMPUTED AND REPORTED SEPARATE FROM THE ENCLOSED APARTMENT AREA.  
 (CPR: 6/1/18) (AUTH: HRS SECT. 514A-45) (IMP: SECT. 514A-172)

1  
 CPR-35  
 SCALE: NTS  
 EXTERIOR ELEVATIONS - BUILDING TYPE 'C2R'



**Design Partners Incorporated**  
 Architects  
 Planners  
 Interior Design



APR 30, 2024  
 License No. 12345

Revision Number/Description

**Makana Kai**  
 At Wehiani  
 PHASE I  
 WAIKOLOA, SOUTH KOHALA, HAWAII  
 CASTLE & COOKE WAIKOLOA, LLC



Drawing Title  
 BUILDING TYPE 'C2R'  
 EXTERIOR ELEVATIONS

Project Number 23033-02 Date JUNE 8, 2024  
 Drawn CAD Checked CS Designed LT/CS/MS


Drawing Number  
 CPR-3.5

Sheet No. of


THIS CONDOMINIUM MAP MAY CONTAIN FLOOR PLANS AND ELEVATIONS OF APARTMENT TYPES THAT ARE NOT INCLUDED IN THIS PROJECT. PLEASE REFER TO THE SITE PLAN TO DETERMINE THE APARTMENT TYPES THAT ARE INCLUDED IN THIS PROJECT.

THE ELEVATIONS AND FLOOR PLANS SHOWN ARE FAIR REPRESENTATION TO ASSIST THE PUBLIC IN VISUALIZING THE CONDOMINIUM UNITS AND MAY NOT BE ACCURATELY DEPICTED. THE DEVELOPER, ITS AGENTS, ASSOCIATE COMPANIES AND SUPPLIERS RESERVE THE RIGHT TO MODIFY PLANS, SPECIFICATIONS AND FEATURES WITHOUT PRIOR NOTICE OR OBLIGATION. FOR SPECIFIC INFORMATION ON ANY OF THE ABOVE ELEMENTS, PLEASE CONTACT CASTLE & COOKE WAIKOLOA LLC.

**METHOD OF COMPUTING FLOOR AREA**  
 THE FLOOR AREA OF THE APARTMENT OR UNIT SHALL BE COMPUTED AND REPORTED IN THE DECLARATION AND COMMISSION'S PUBLIC REPORT AS NET LIVING AREA. THE LIVING AREA OF THE ENCLOSED PORTION OF THE APARTMENT SHALL BE MEASURED FROM THE INTERIOR SURFACES OF THE APARTMENT PERIMETER WALLS. AREAS OF LANAI OR BALCONY WHICH ARE CONSIDERED AS PART OF THE APARTMENT, SHALL BE COMPUTED AND REPORTED SEPARATE FROM THE ENCLOSED APARTMENT AREA.  
 (ETP. 6/2/09) (AUTH. HRS. SECT. 344A-42) (EP. SECT. 344A-112)

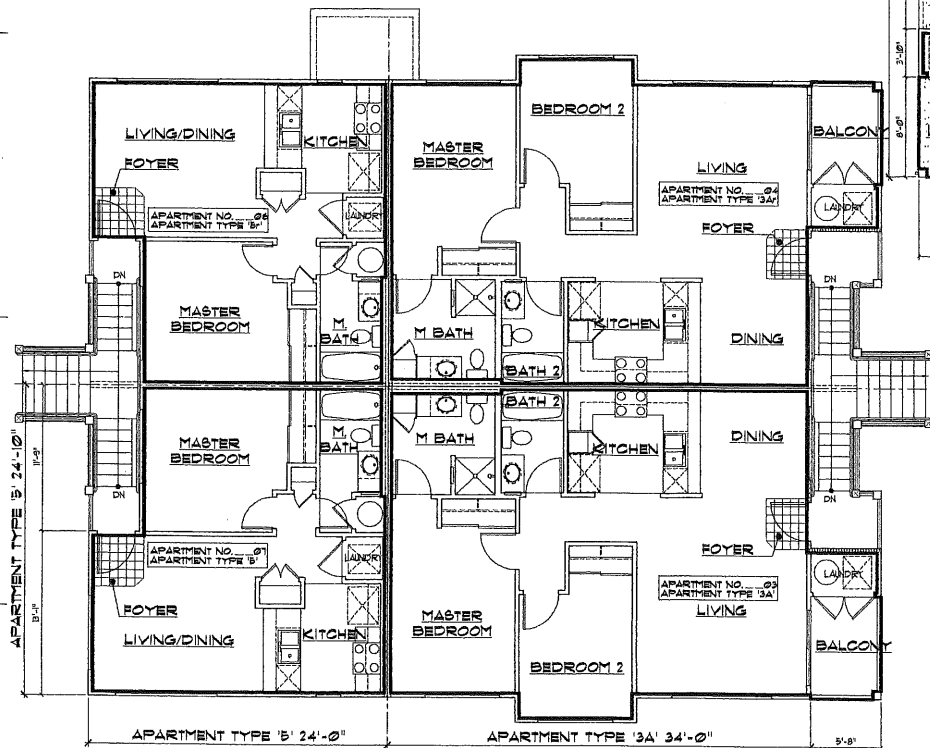

7 SECOND FLOOR PLAN - BUILDING TYPE 'D'  
 SCALE: N16

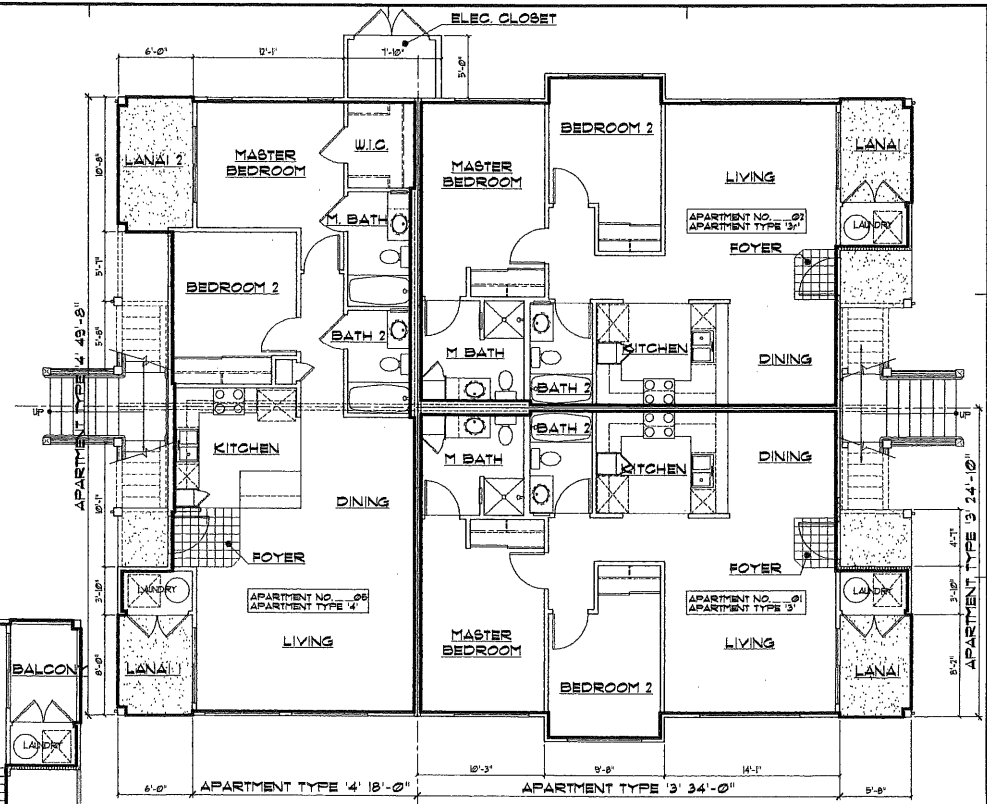

1 FIRST FLOOR PLAN - BUILDING TYPE 'D'  
 SCALE: N16

CFR AREA CALCULATIONS

UNIT 3 / 3R	
LIVING	829 SF
LANDRY	11 SF
LANAI	48 SF
TOTAL	888 SF

UNIT 3A / 3AR	
LIVING	829 SF
LANDRY	11 SF
BALCONY	43 SF
TOTAL	883 SF

UNIT 4 / 4R	
LIVING	909 SF
LANDRY	18 SF
LANAI 1	48 SF
LANAI 2	62 SF
TOTAL	1037 SF

UNIT 5 / 5R	
LIVING	914 SF
TOTAL	914 SF

**Design Partners Incorporated**  
 Architects  
 Planning  
 Interior Design

REGISTERED PROFESSIONAL ARCHITECT  
 No. 5212 APR 30, 2008  
 LICENSED ARCHITECT

Revision Number/Description

**Makana Kai**  
 At Wehilani  
 PHASE I  
 WAIKOLOA, SOUTH KOHALA, HAWAII  
 CASTLE & COOKE WAIKOLOA, LLC

Project Name


Drawing Title BUILDING TYPE 'D' FLOOR PLANS

Project Number 03033-02 Date JUNE 8, 2008  
 Drawn CAD Checked CA Designed LY/CS/MS


Drawing Number

**CPR-4.0**

Sheet No. of

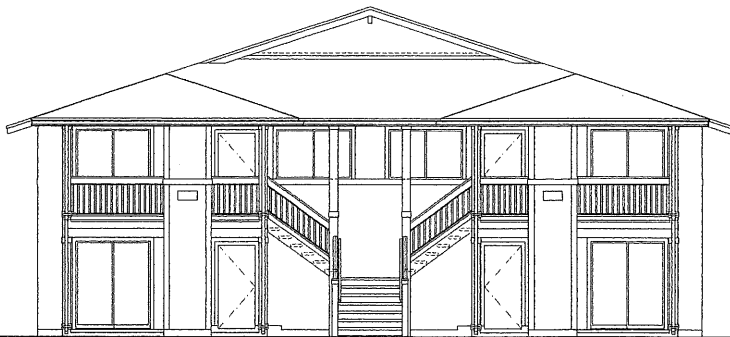


RIGHT ELEVATION - BUILDING 'D'

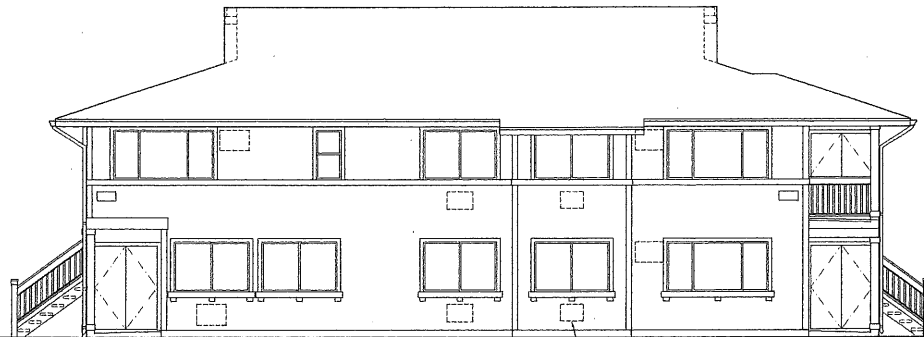

FRONT ELEVATION - BUILDING 'D'



LEFT ELEVATION - BUILDING 'D'

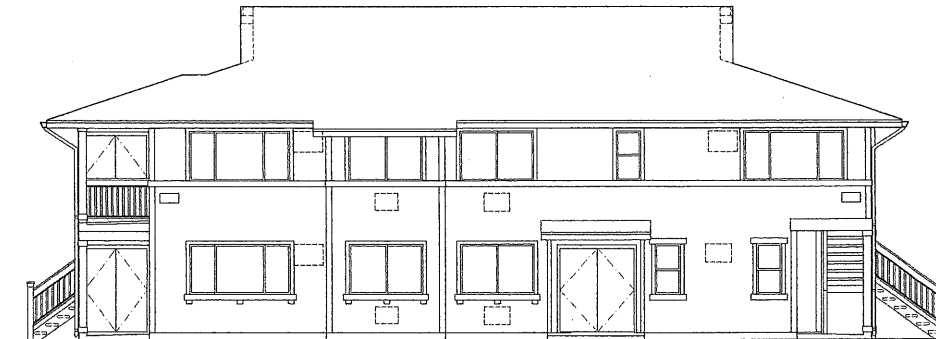

REAR ELEVATION - BUILDING 'D'

THIS CONDOMINIUM MAP MAY CONTAIN FLOOR PLANS AND ELEVATIONS OF APARTMENT TYPES THAT ARE NOT INCLUDED IN THIS PROJECT. PLEASE REFER TO THE SITE PLAN TO DETERMINE THE APARTMENT TYPES THAT ARE INCLUDED IN THIS PROJECT.

THE ELEVATIONS AND FLOOR PLANS SHOWN ARE FAIR REPRESENTATION TO ASSIST THE PUBLIC IN VISUALIZING THE CONDOMINIUM UNITS AND MAY NOT BE ACCURATELY DEPICTED. THE DEVELOPER, ITS AGENTS, ASSOCIATE COMPANIES AND SUPPLIERS RESERVE THE RIGHT TO MODIFY PLANS, SPECIFICATIONS AND FEATURES WITHOUT PRIOR NOTICE OR OBLIGATION. FOR SPECIFIC INFORMATION ON ANY OF THE ABOVE ELEMENTS, PLEASE CONTACT CASTLE & COOKE WAIKOLOA LLC.

**METHOD OF COMPUTING FLOOR AREA**  
 THE FLOOR AREA OF THE APARTMENT OR UNIT SHALL BE COMPUTED AND REPORTED IN THE DECLARATION AND COMMONS PUBLIC REPORT AS NET LIVING AREA. THE LIVING AREA OF THE ENCLOSED PORTION OF THE APARTMENT SHALL BE MEASURED FROM THE INTERIOR SURFACES OF THE APARTMENT PERIMETER WALLS, AREAS OF LANAI OR BALCONY, WHICH ARE CONSIDERED AS PART OF THE APARTMENT, SHALL BE COMPUTED AND REPORTED SEPARATE FROM THE ENCLOSED APARTMENT AREA.  
 (CPR, 6/12/80 (AUTH. HRS SECT. 514A-45) (1979, SECT. 514A-112))



EXTERIOR ELEVATIONS - BUILDING TYPE 'D'  
 SCALE: NTS



Revision Number/Description

**Makana Kai**  
 At Wehilani  
 PHASE I  
 WAIKOLOA SOUTH KOHALA, HAWAII  
 CASTLE & COOKE WAIKOLOA, LLC



Drawing Title: BUILDING TYPE 'D' EXTERIOR ELEVATIONS

Project Number	Date
03033-01	JUNE 8, 2006
Drawn	Checked
CAD	CS
Designed	LTC/MS


Drawing Number: CPR-4.1

Sheet No. of







RIGHT ELEVATION - BUILDING 'DIR'

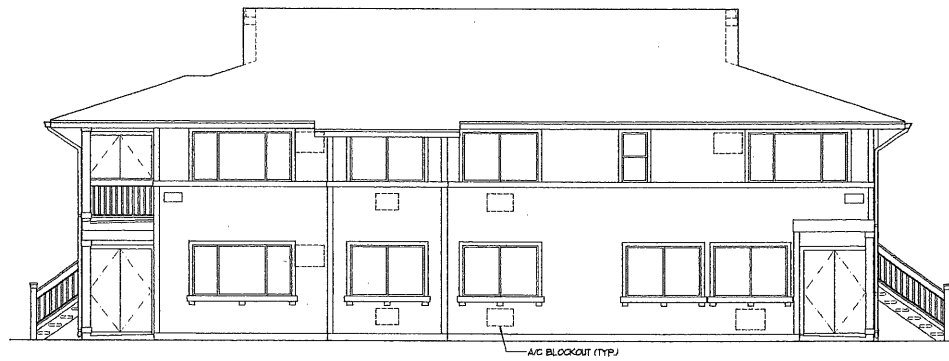

FRONT ELEVATION - BUILDING 'DIR'

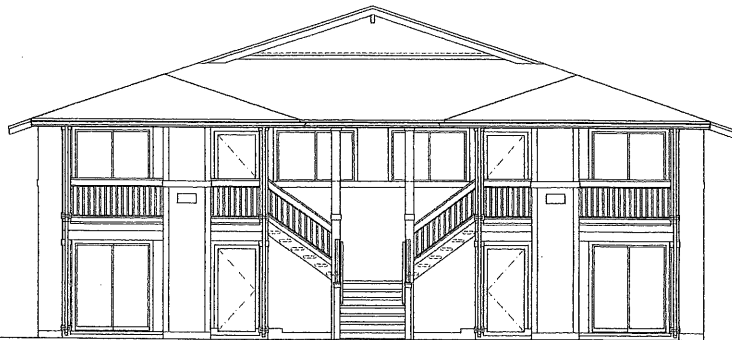

LEFT ELEVATION - BUILDING 'DIR'

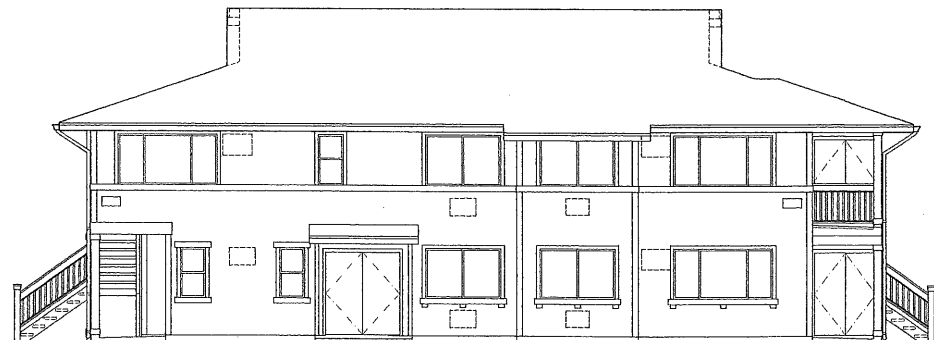

REAR ELEVATION - BUILDING 'DIR'

THIS CONDOMINIUM MAP MAY CONTAIN FLOOR PLANS AND ELEVATIONS OF APARTMENT TYPES THAT ARE NOT INCLUDED IN THIS PROJECT. PLEASE REFER TO THE SITE PLAN TO DETERMINE THE APARTMENT TYPES THAT ARE INCLUDED IN THIS PROJECT.

THE ELEVATIONS AND FLOOR PLANS SHOWN ARE FAIR REPRESENTATION TO ASSIST THE PUBLIC IN VISUALIZING THE CONDOMINIUM UNITS AND MAY NOT BE ACCURATELY DEPICTED. THE DEVELOPER, ITS AGENTS, ASSOCIATE COMPANIES AND SUPPLIERS RESERVE THE RIGHT TO MODIFY PLANS, SPECIFICATIONS AND FEATURES WITHOUT PRIOR NOTICE OR OBLIGATION. FOR SPECIFIC INFORMATION ON ANY OF THE ABOVE ELEMENTS, PLEASE CONTACT CASTLE & COOKE WAIKOLOA LLC.

**METHOD OF COMPUTING FLOOR AREA**  
 THE FLOOR AREA OF THE APARTMENT OR UNIT SHALL BE COMPUTED AND REPORTED IN THE DECLARATION AND COMMISSION'S PUBLIC REPORT AS NET LIVING AREA. THE LIVING AREA OF THE ENCLOSED PORTION OF THE APARTMENT SHALL BE MEASURED FROM THE INTERIOR SURFACES OF THE APARTMENT PERIMETER WALLS. AREAS OF LANAI OR BALCONY, WHICH ARE CONSIDERED AS PART OF THE APARTMENT, SHALL BE COMPUTED AND REPORTED SEPARATE FROM THE ENCLOSED APARTMENT AREA.  
 (H.P.S. 6-0200) (A.U.T.H. H.R.S. SECT. 514A-43) (H.P.S. SECT. 514A-172)

1 EXTERIOR ELEVATIONS - BUILDING TYPE 'DIR'  
 PR-44 SCALE: NTS



Design Partners Incorporated  
 Architects  
 Planning  
 Interior Design



Signatures  
 APR 30, 2020  
 Daniel N. Cooke  
 State of Hawaii  
 License No. 1421

Revision Number/Description

**Makana Kai**  
 At Wehilani  
 PHASE I  
 WAIKOLOA, SOUTH KOHALA, HAWAII  
 CASTLE & COOKE WAIKOLOA, LLC




Drawing Title			
BUILDING TYPE 'DIR' EXTERIOR ELEVATIONS			
Project Number	Date		
03033-02	JUNE 8, 2020		
Drawn	Checked	Designed	
CAD	CB	LTC/MS	

Drawing Number  
**CPR-4.4**  
 Sheet No. of




RIGHT ELEVATION - BUILDING 'D2R'

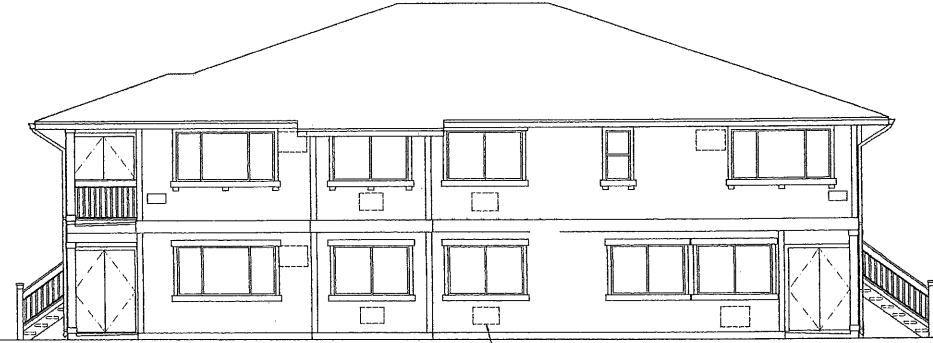

FRONT ELEVATION - BUILDING 'D2R'



LEFT ELEVATION - BUILDING 'D2R'

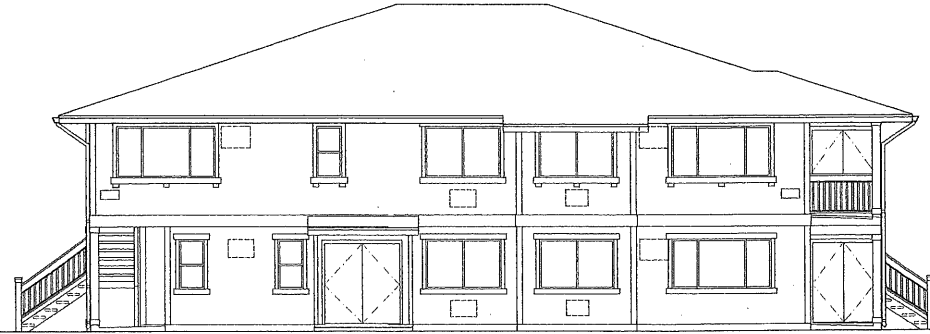

REAR ELEVATION - BUILDING 'D2R'

A/C BLOCKOUT (TYP)

THIS CONDOMINIUM MAP MAY CONTAIN FLOOR PLANS AND ELEVATIONS OF APARTMENT TYPES THAT ARE NOT INCLUDED IN THIS PROJECT. PLEASE REFER TO THE SITE PLAN TO DETERMINE THE APARTMENT TYPES THAT ARE INCLUDED IN THIS PROJECT.

THE ELEVATIONS AND FLOOR PLANS SHOWN ARE FAIR REPRESENTATION TO ASSIST THE PUBLIC IN VISUALIZING THE CONDOMINIUM UNITS AND MAY NOT BE ACCURATELY DEPICTED. THE DEVELOPER, ITS AGENTS, ASSOCIATE COMPANIES AND SUPPLIERS RESERVE THE RIGHT TO MODIFY PLANS, SPECIFICATIONS AND FEATURES WITHOUT PRIOR NOTICE OR OBLIGATION. FOR SPECIFIC INFORMATION ON ANY OF THE ABOVE ELEMENTS, PLEASE CONTACT CASTLE & COOKE WAIKOLOA, LLC.

**METHOD OF COMPUTING FLOOR AREA**  
 THE FLOOR AREA OF THE APARTMENT OR UNIT SHALL BE COMPUTED AND REPORTED IN THE DECLARATION AND COMMISSION'S PUBLIC REPORT AS NET LIVING AREA. THE LIVING AREA OF THE ENCLOSED PORTION OF THE APARTMENT SHALL BE MEASURED FROM THE INTERIOR SURFACES OF THE APARTMENT PERIMETER WALLS. AREAS OF LANAI OR BALCONY, WHICH ARE CONSIDERED AS PART OF THE APARTMENT, SHALL BE COMPUTED AND REPORTED SEPARATELY FROM THE ENCLOSED APARTMENT AREA. (CFR. 6/12/01) (AUTH. HRS. SECT. 514A-45) (IMP. SECT. 514A-112)

EXTERIOR ELEVATIONS - BUILDING TYPE 'D2R'  
 SCALE: NTS



**Design Partners Incorporated**  
 Architecture  
 Planning  
 Interior Design



APR 30 2020  
 The work was prepared by or under the supervision of the architect and is not to be used by anyone else.

Revision Number/Description

**Makana Kai**  
 At Wehiani  
 PHASE I  
 WAIKOLOA, SOUTH KOHALA, HAWAII  
 CASTLE & COOKE WAIKOLOA, LLC



Project Name: BUILDING TYPE 'D2R' EXTERIOR ELEVATIONS

Project Number: 03033-07 Date: JAN 8 2020  
 Drawn: CAD Checked: CS Designed: LTY/C&C

Drawing Number: CPR-4.5

Sheet No. of